


Shoppes at Questover

12536 Olive Blvd, Suite G

As-Built 1,334 Sq. Ft.

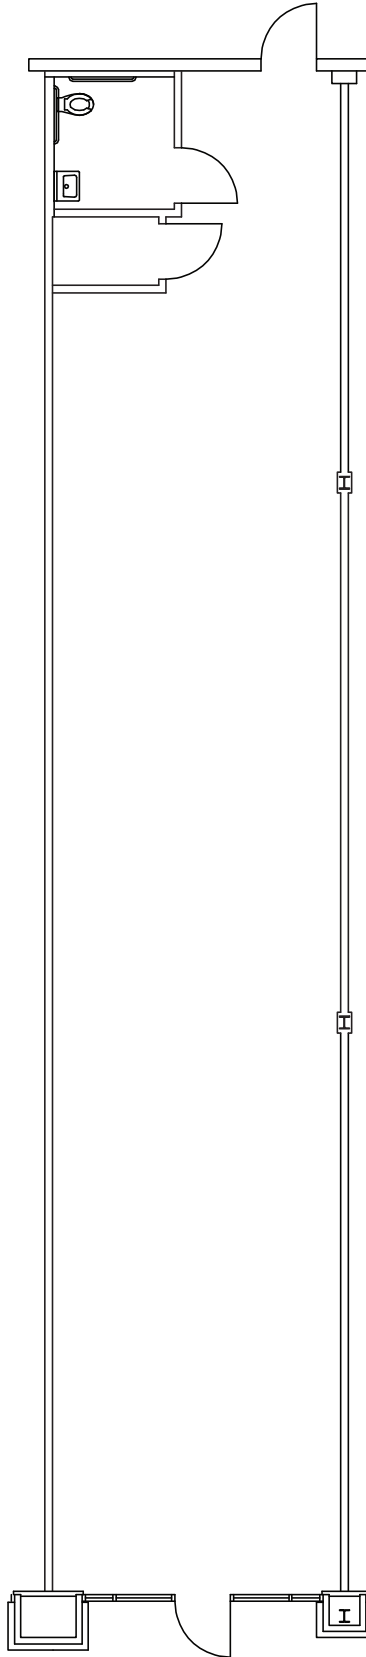

* Dimensions are Deemed
as Accurate but not to Scale

