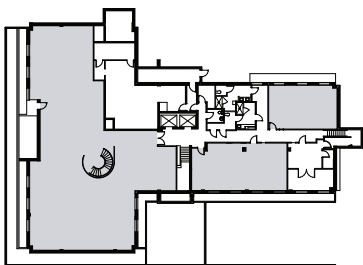
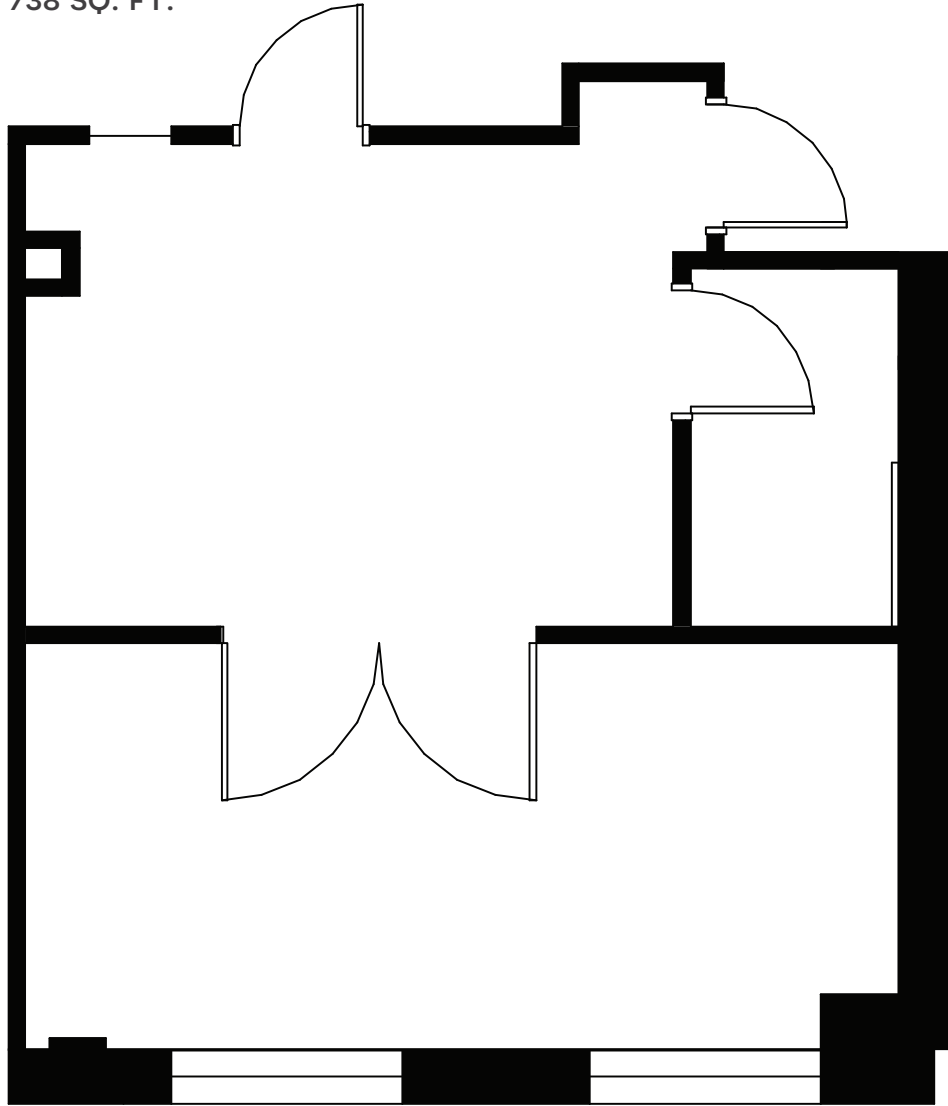

2ND & JO

2401 EAST 2ND AVENUE
SUITE G40
AS-BUILT 738 SQ. FT.



* Dimensions are Deemed
as Accurate but not to Scale

FOR MORE INFORMATION, PLEASE CONTACT:

Blake Holcomb
First Vice President
+1 303 583 2022
blake.holcomb@cbre.com

Brian Hutt
First Vice President
+1 303 583 2041
brian.hutt@cbre.com

OWNED BY
ALTUS

LEASED & MANAGED BY
CBRE