



# 600 Parkway

Suite 110

As-Built 4,256 Sq. Ft.

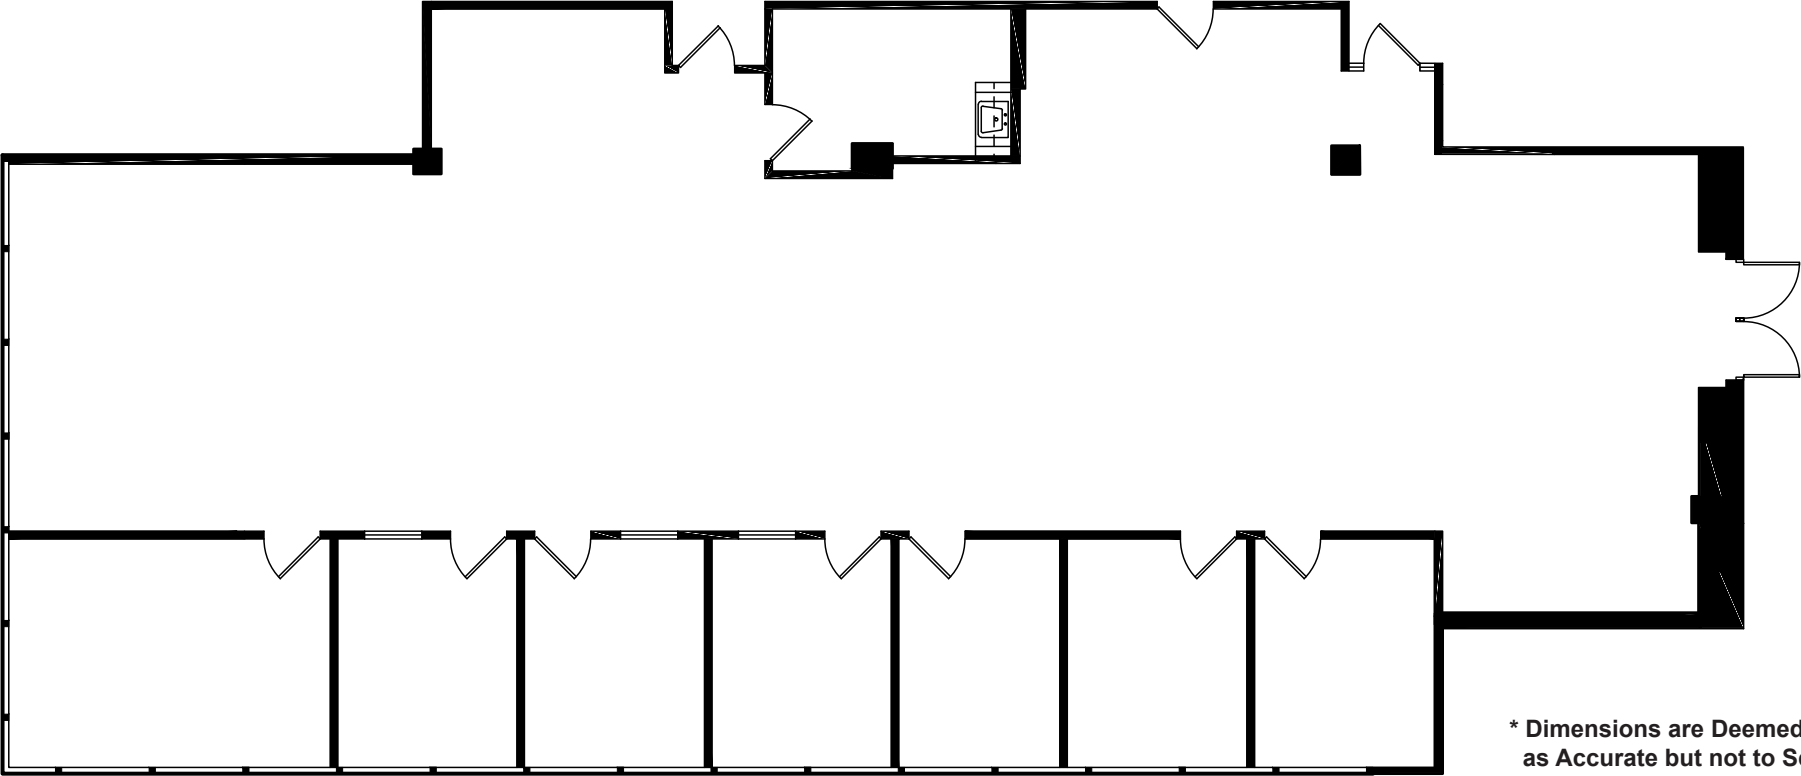

\* Dimensions are Deemed as Accurate but not to Scale

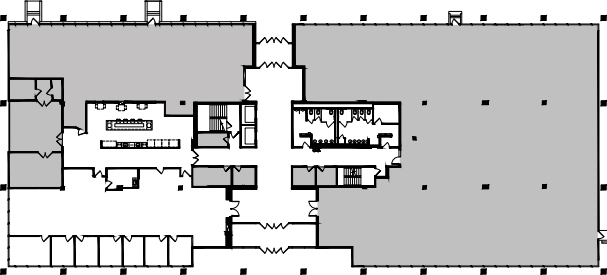

**NEWMARK**  
ZIMMER

