
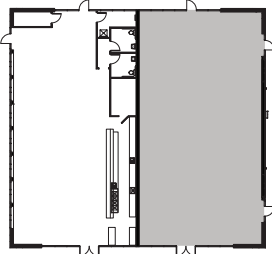


CREVE COEUR *Pavilion*

10453 Olive Blvd.

As-Built 3,000 Ft.

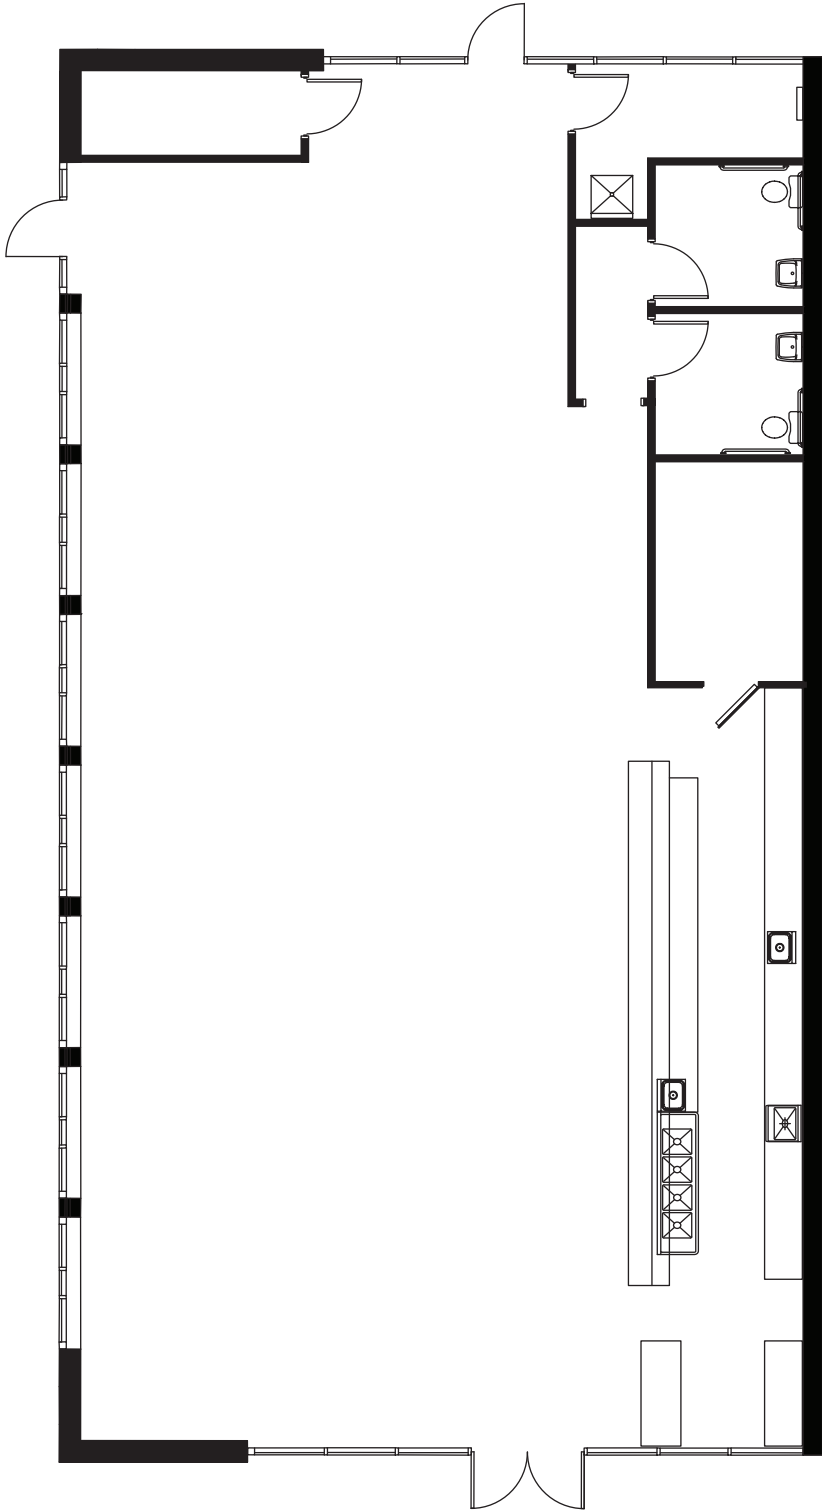

* Dimensions are Deemed as Accurate but not to Scale