


CREVE COEUR *Pavilion*

10590 Old Olive St. Rd.
As-Built 5,169 Ft.

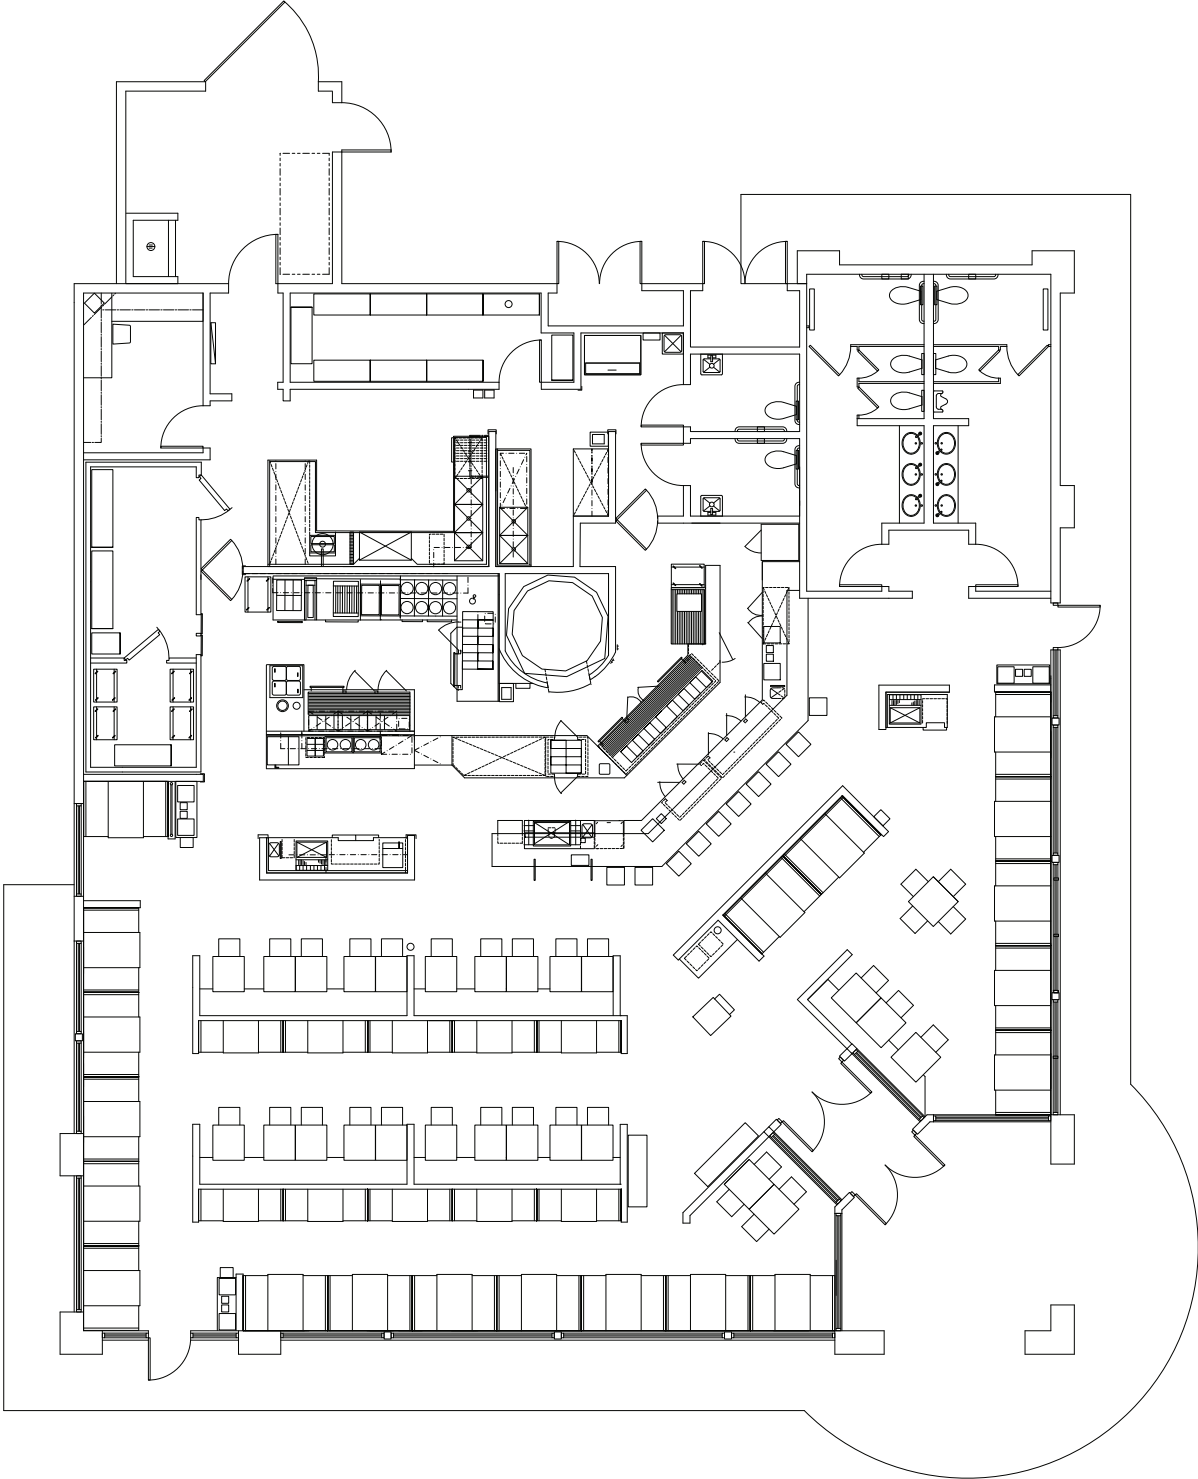

* Dimensions are Deemed
as Accurate but not to Scale