


# CREVE COEUR Pavilion

10560 Old Olive St. Rd.  
Suite 220  
As-Built      2,232 Ft.

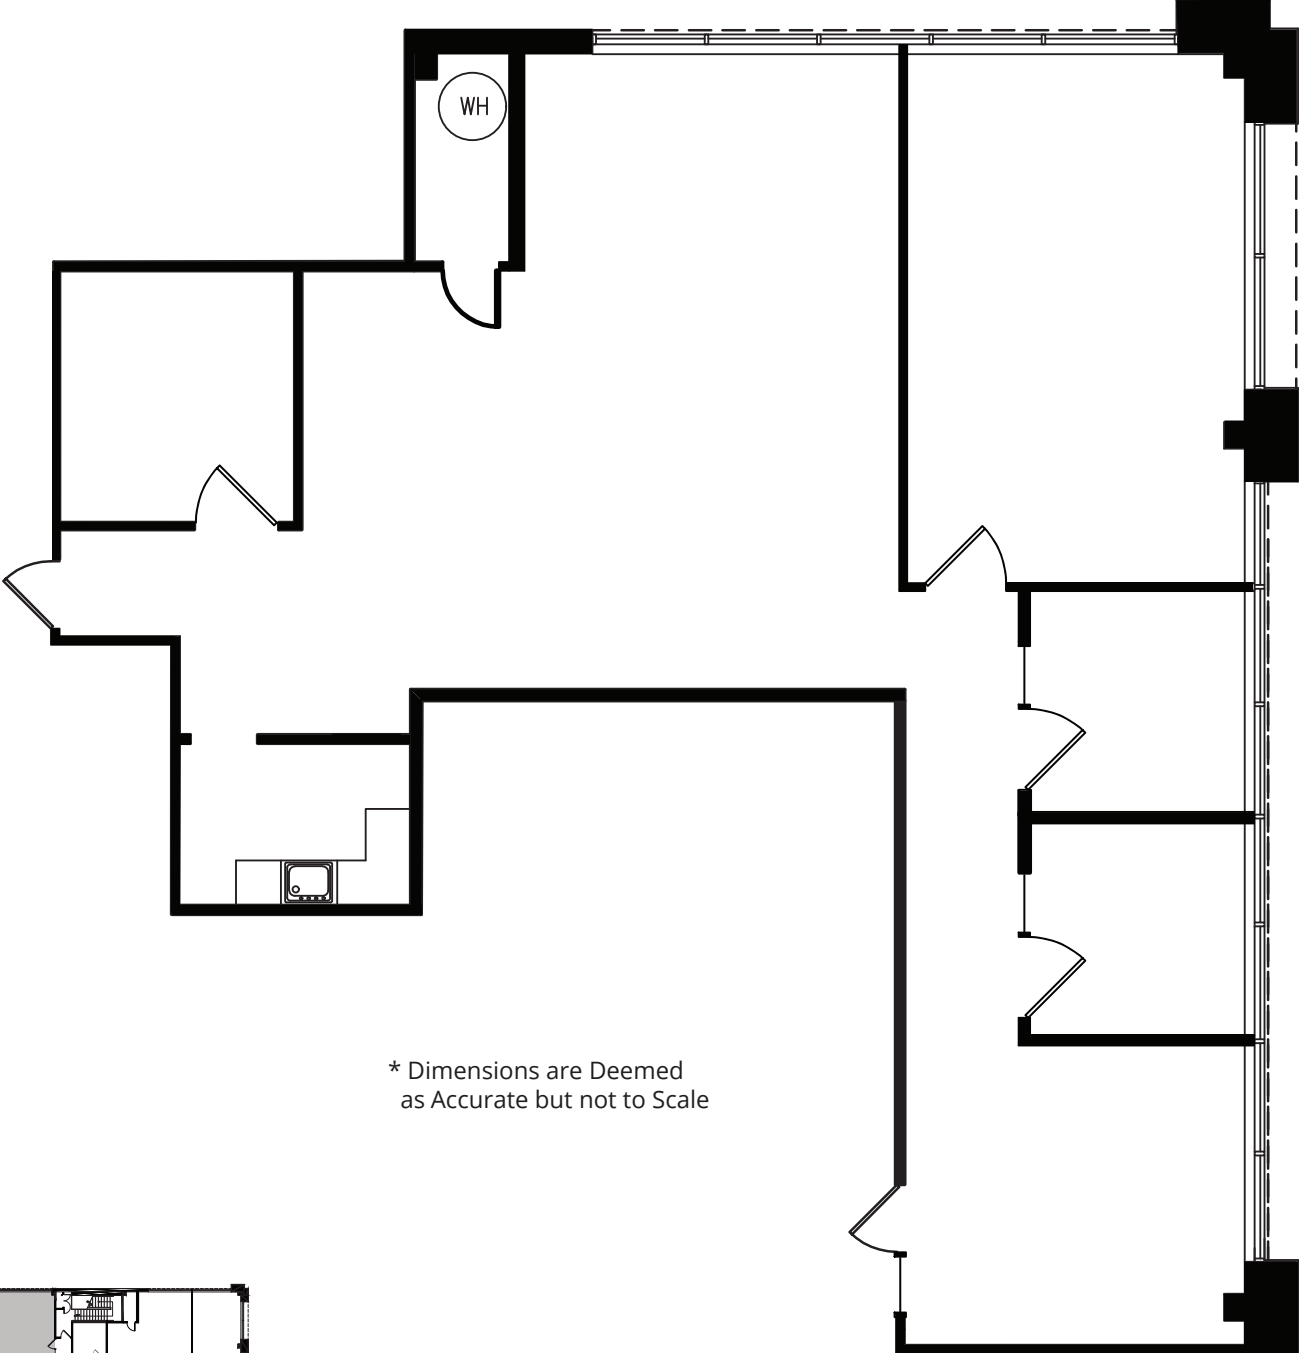

\* Dimensions are Deemed as Accurate but not to Scale

