


# CREVE COEUR Pavilion

10560 Old Olive St. Rd.  
Suite 230  
As-Built      1,161 Ft.



\* Dimensions are Deemed  
as Accurate but not to Scale

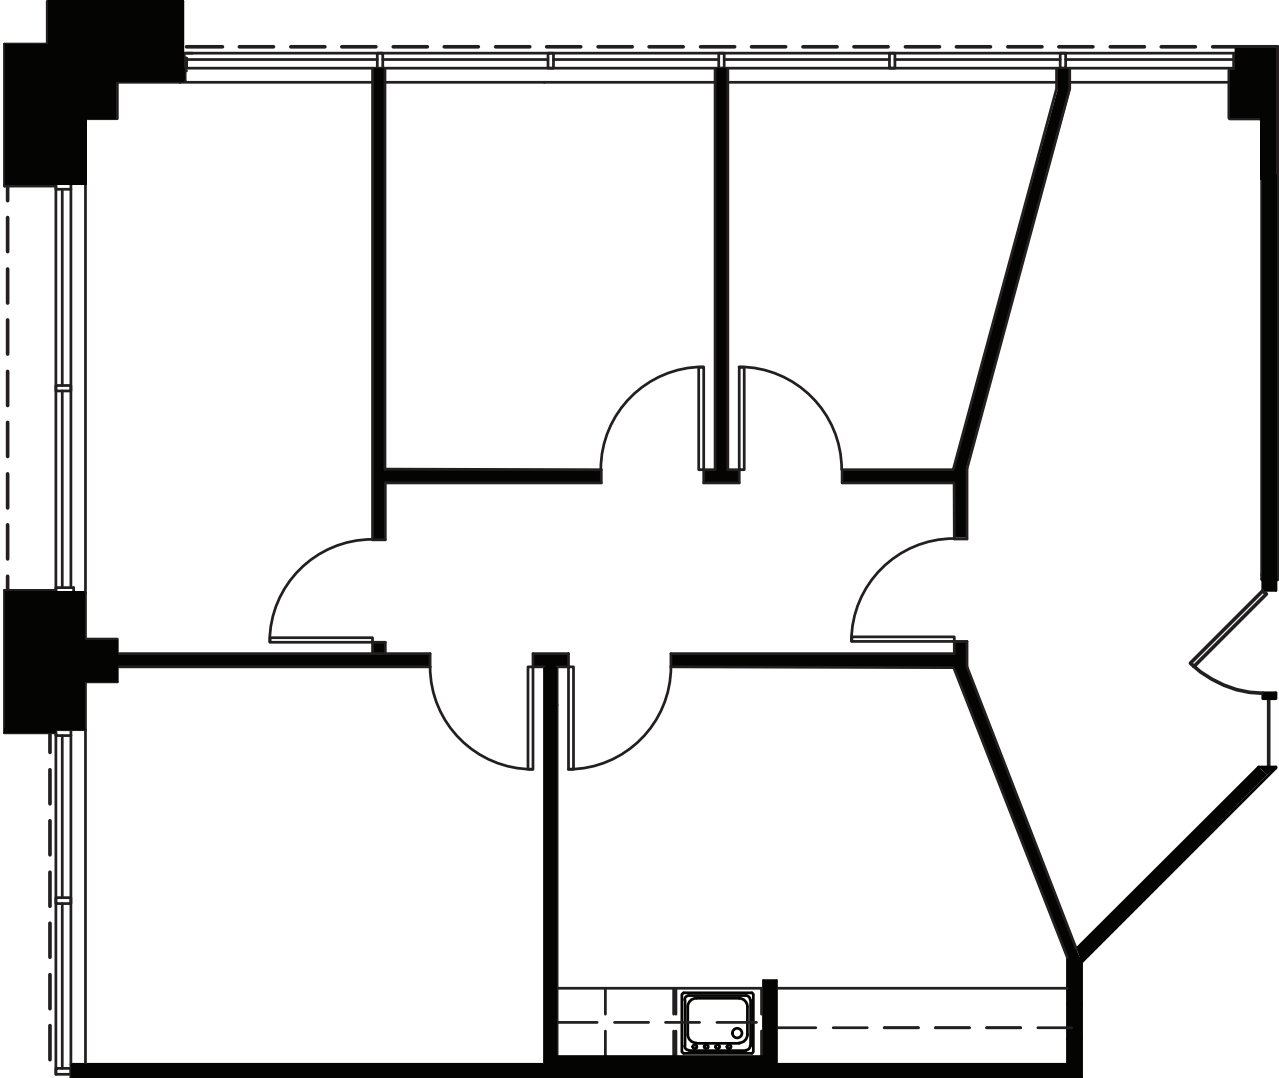