


CREVE COEUR Pavilion

10552 Old Olive St. Rd.

As-Built 1,059 Sq. Ft.

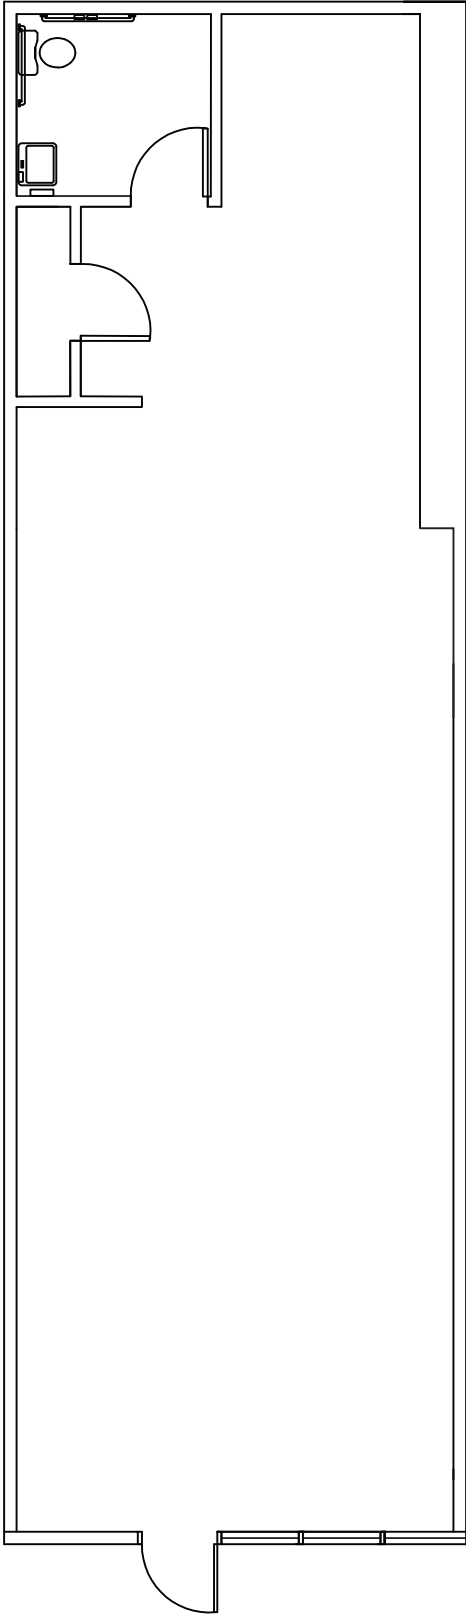

* Dimensions are Deemed as Accurate but not to Scale

