


Lakeside Shoppes at Winghaven

3028 Winghaven Blvd

As-Built 1,296 Sq. Ft.

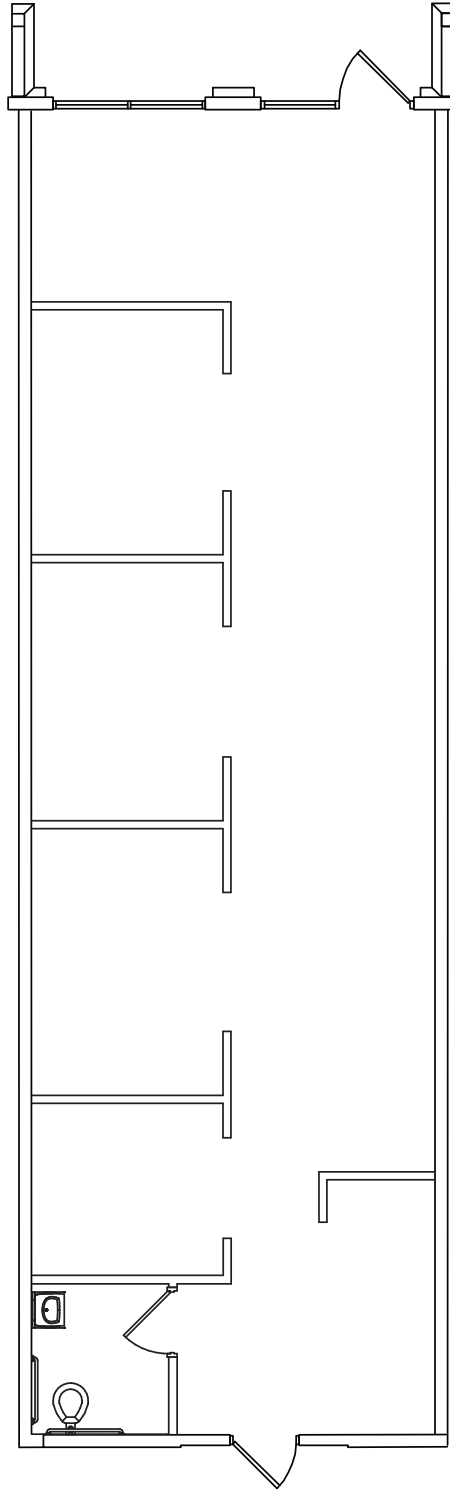

** Dimensions are Deemed
as Accurate but not to Scale*



OWNED & MANAGED BY



LEASED BY

