


Lakeside Shoppes at Winghaven

3046-3050 Winghaven Blvd

As-Built 3,750 Sq. Ft.

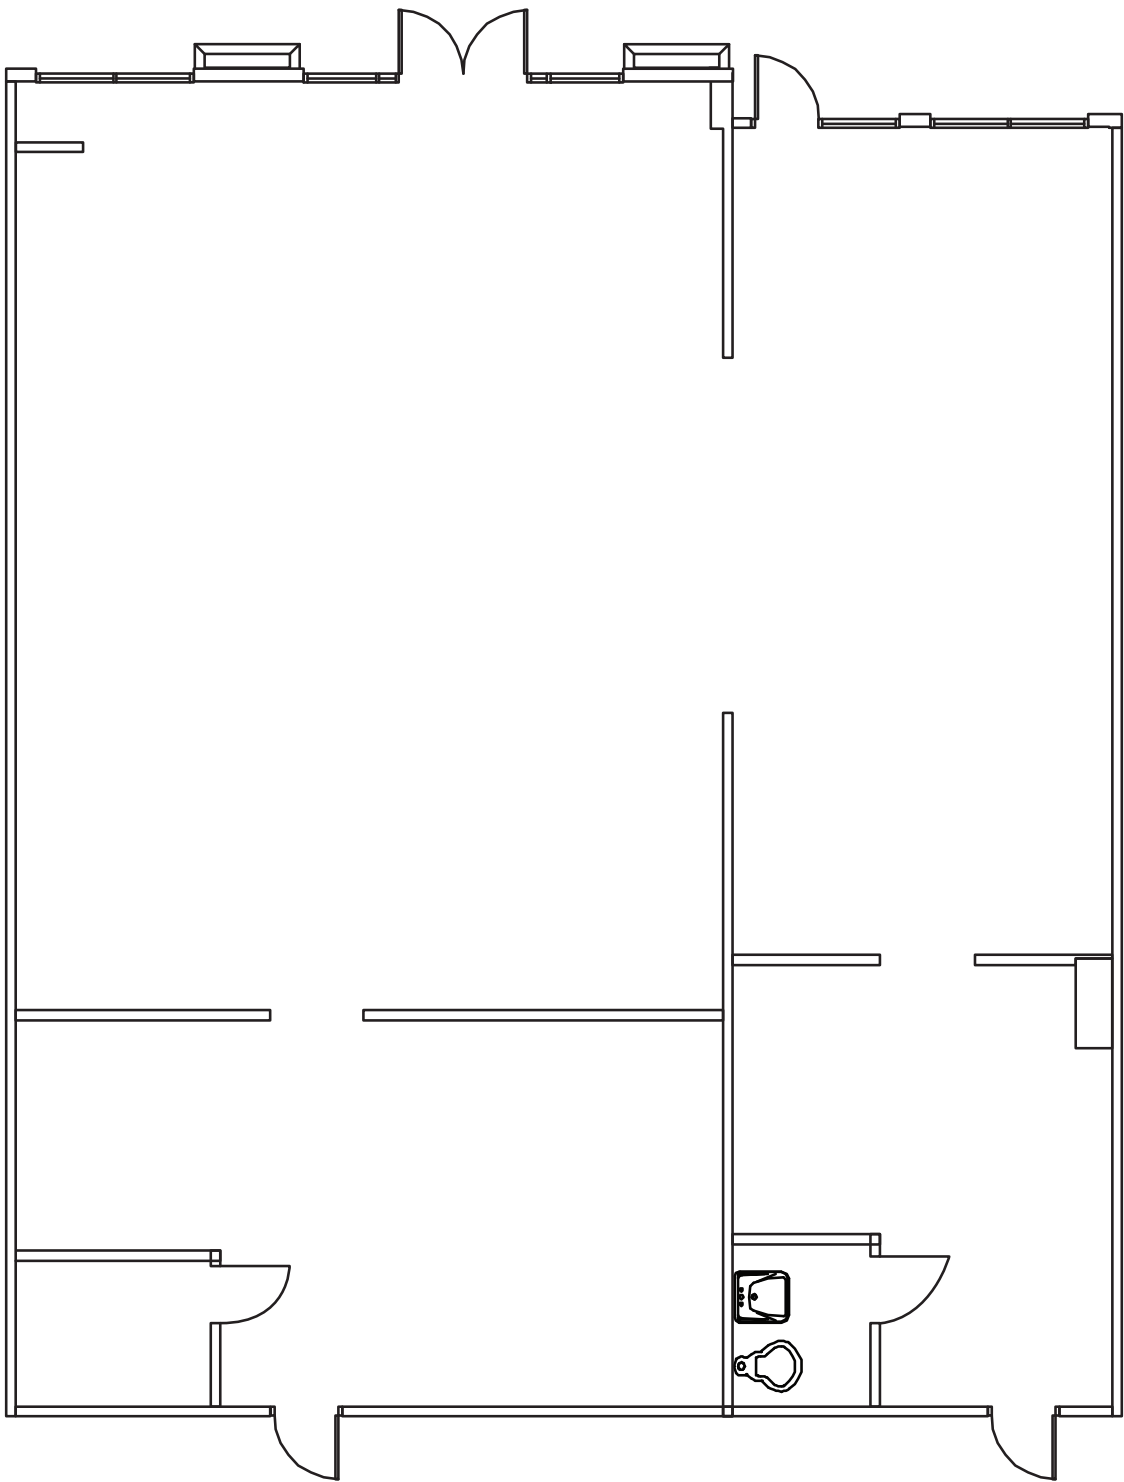

** Dimensions are Deemed
as Accurate but not to Scale*



OWNED & MANAGED BY



LEASED BY

