


# Lakeside Shoppes at Winghaven

3046-3050 Winghaven Blvd

As-Built      3,750 Sq. Ft.

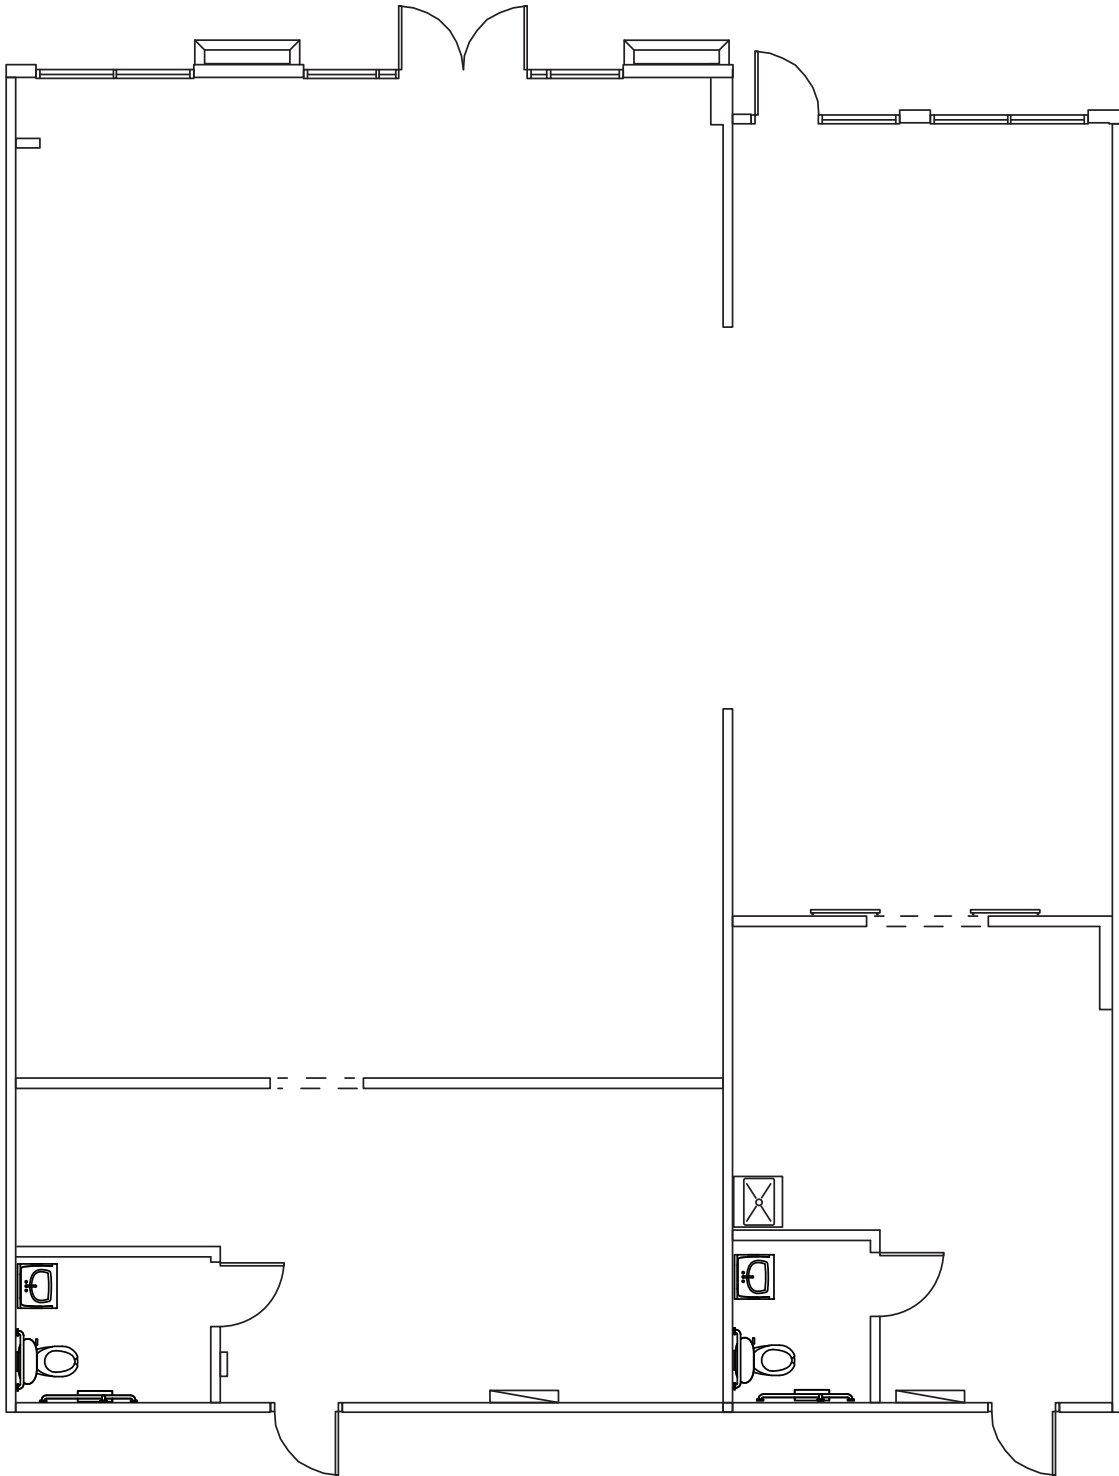

*\* Dimensions are Deemed  
as Accurate but not to Scale*



OWNED & MANAGED BY



LEASED BY

