


Lakeside Shoppes at Winghaven

3046 Winghaven Blvd

As-Built 2,454 Sq. Ft.

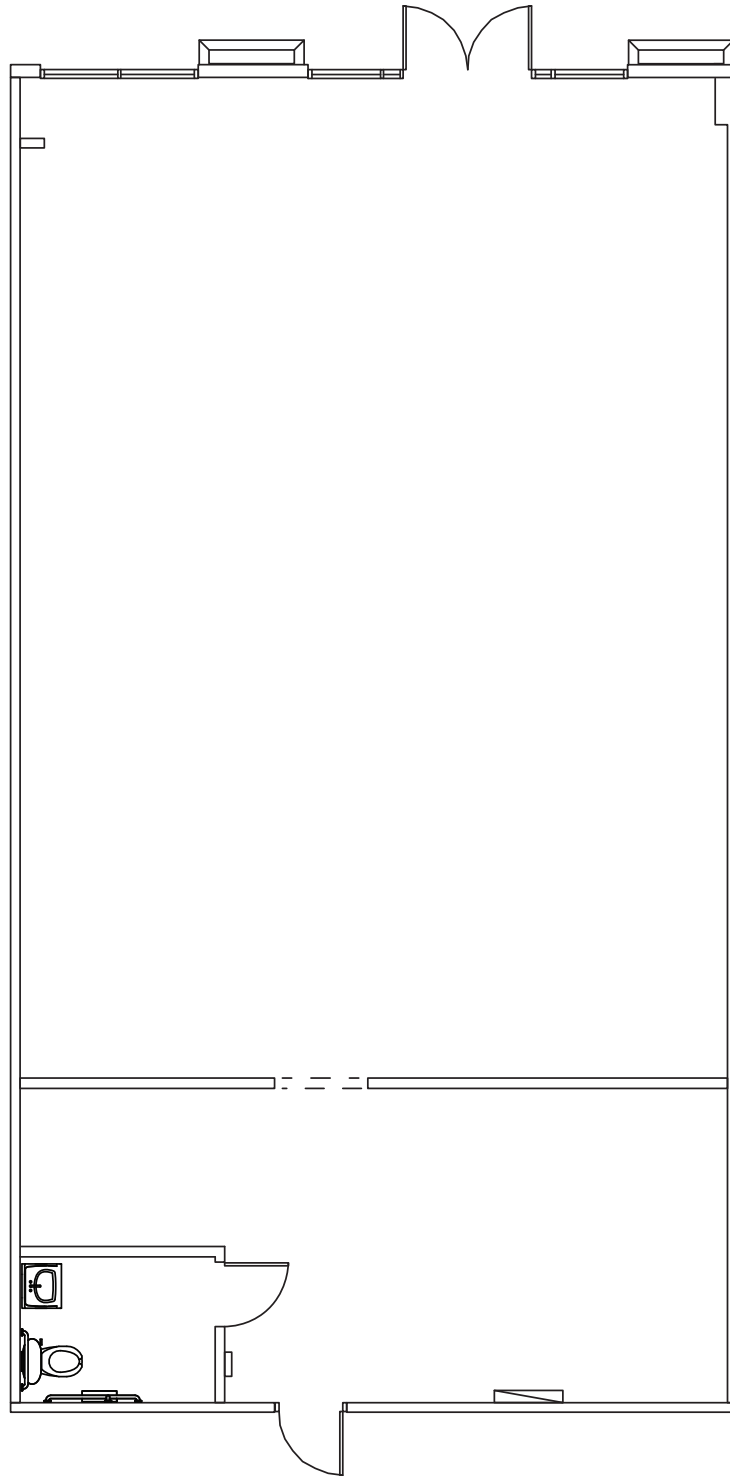

** Dimensions are Deemed
as Accurate but not to Scale*



OWNED & MANAGED BY



LEASED BY

