


Lakeside Shoppes at Winghaven

3086 Winghaven Blvd

As-Built 1,400 Sq. Ft.

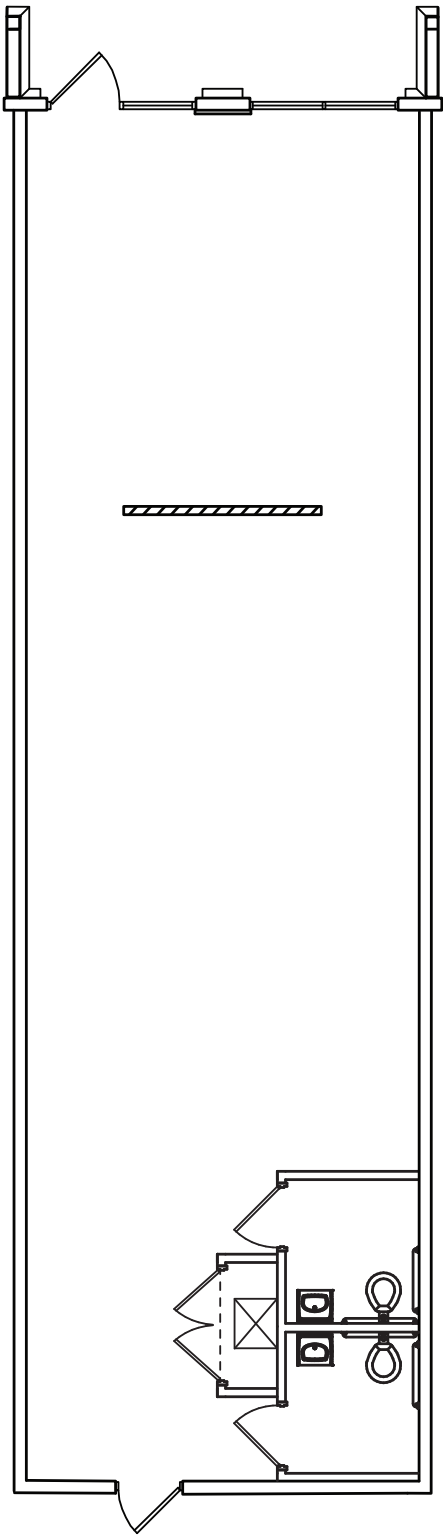

** Dimensions are Deemed
as Accurate but not to Scale*



OWNED & MANAGED BY



LEASED BY

