
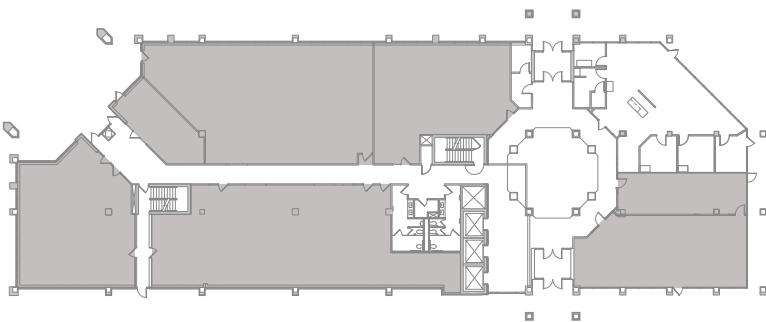


EDINBOROUGH

CORPORATE CENTER

Suite 100

As-Built 2,086 Sq. Ft.

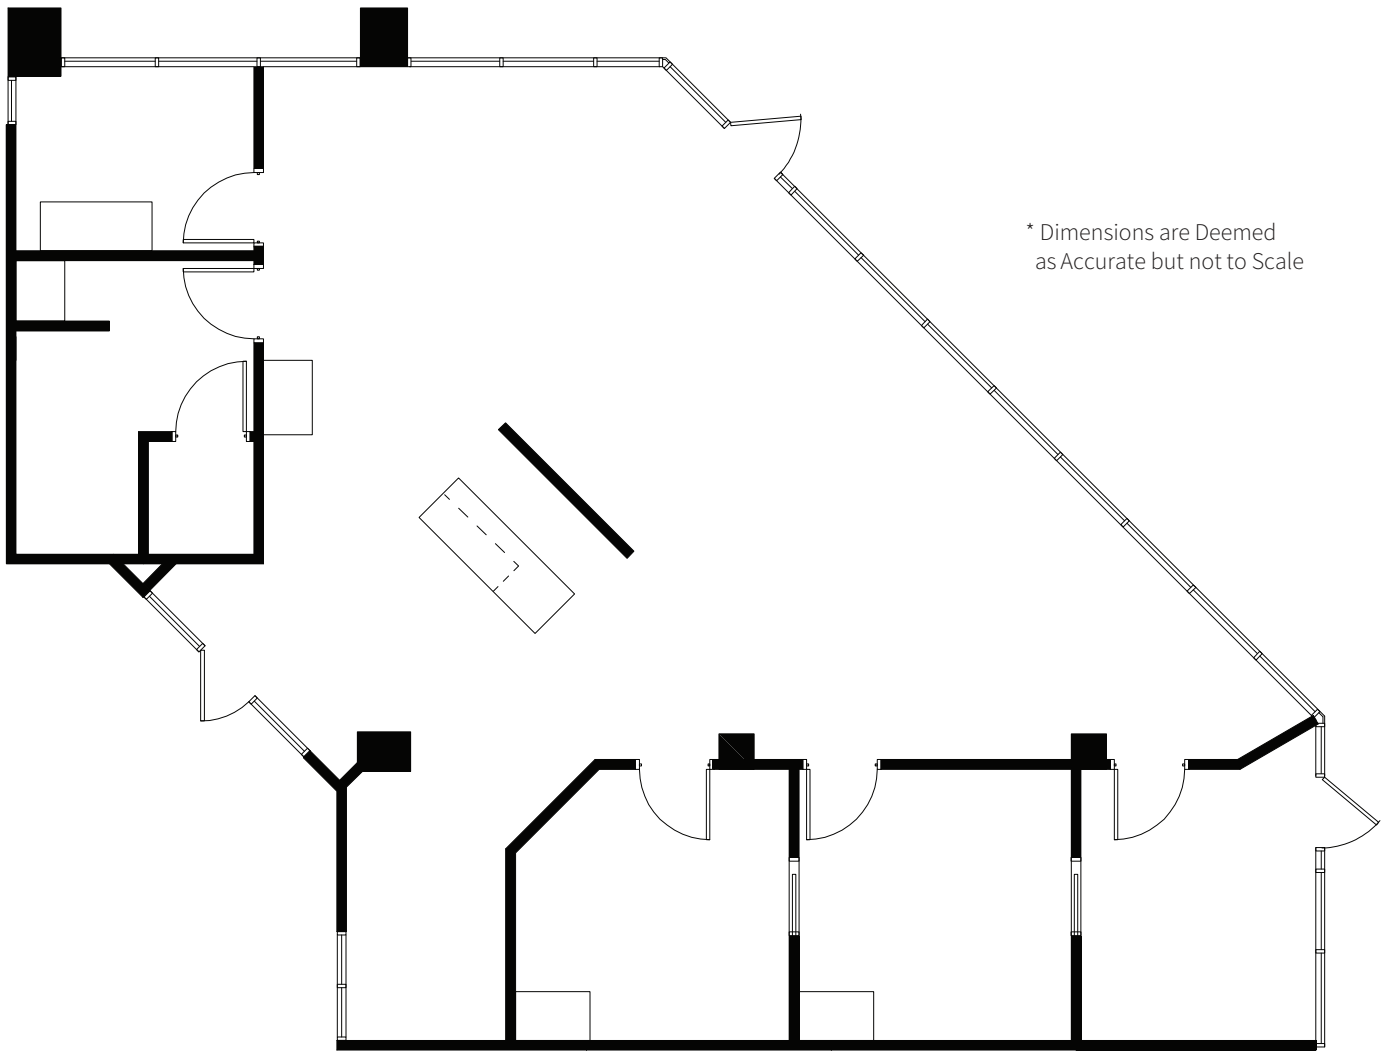

OWNED & MANAGED BY



LEASED BY

