



MINNESOTA CENTER

Suite 1080

As-Built 3,365 Sq. Ft.

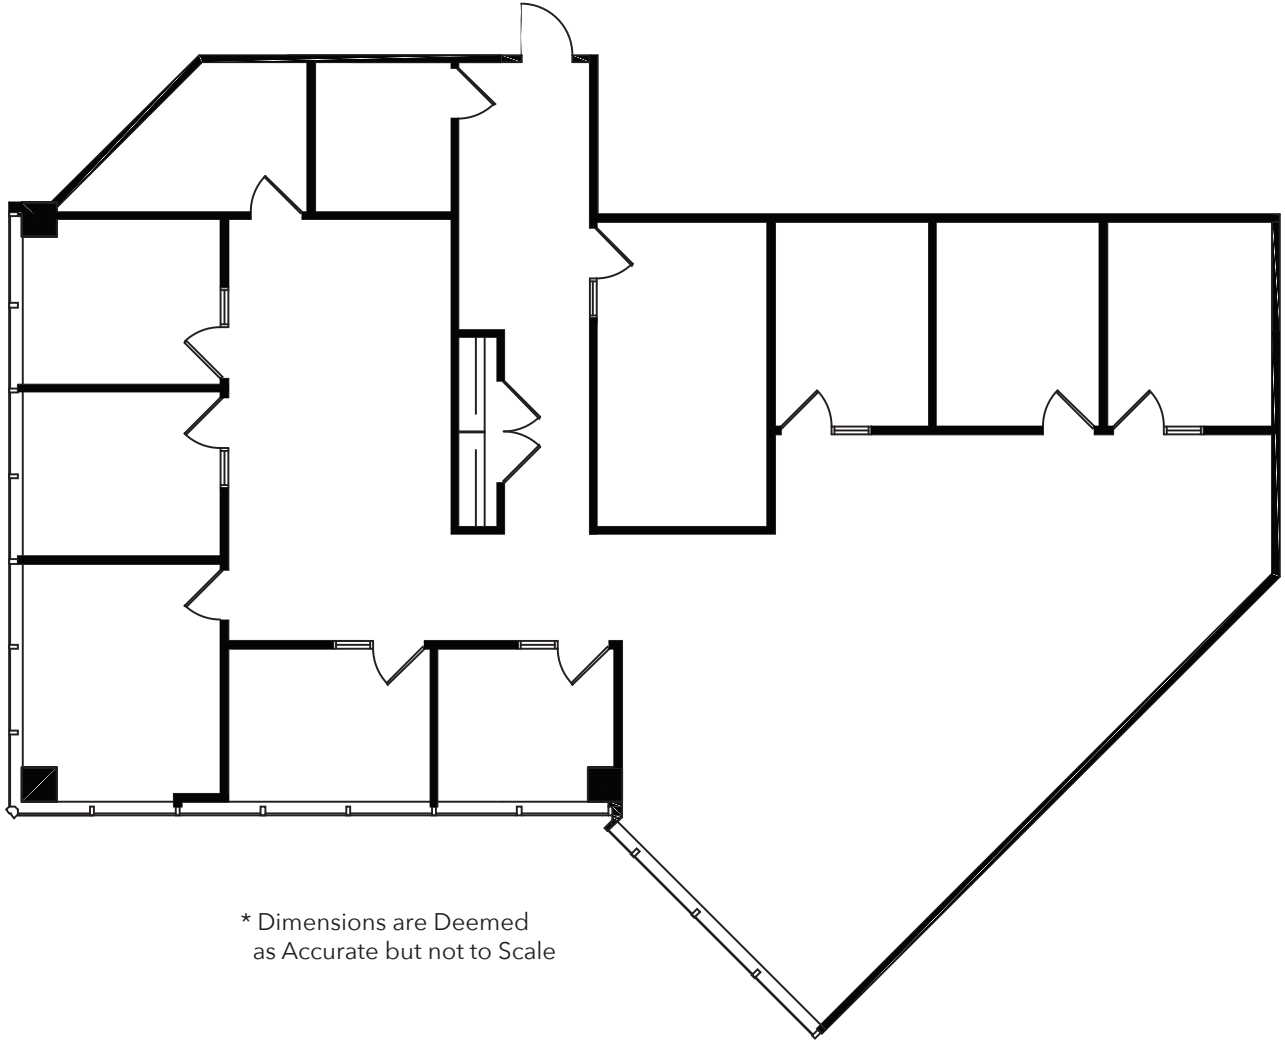

* Dimensions are Deemed
as Accurate but not to Scale

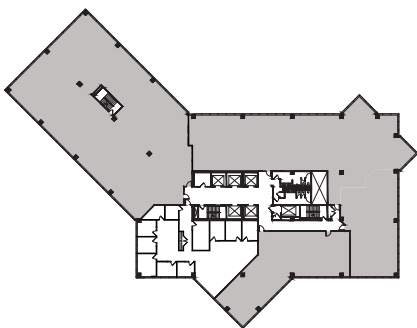

OWNED & MANAGED BY



LEASED BY

