



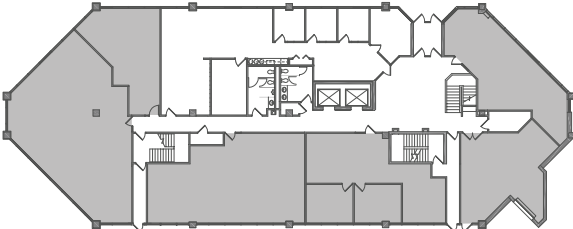

WEST RIDGE

Suite 110

As-Built 2,193 Sq. Ft.

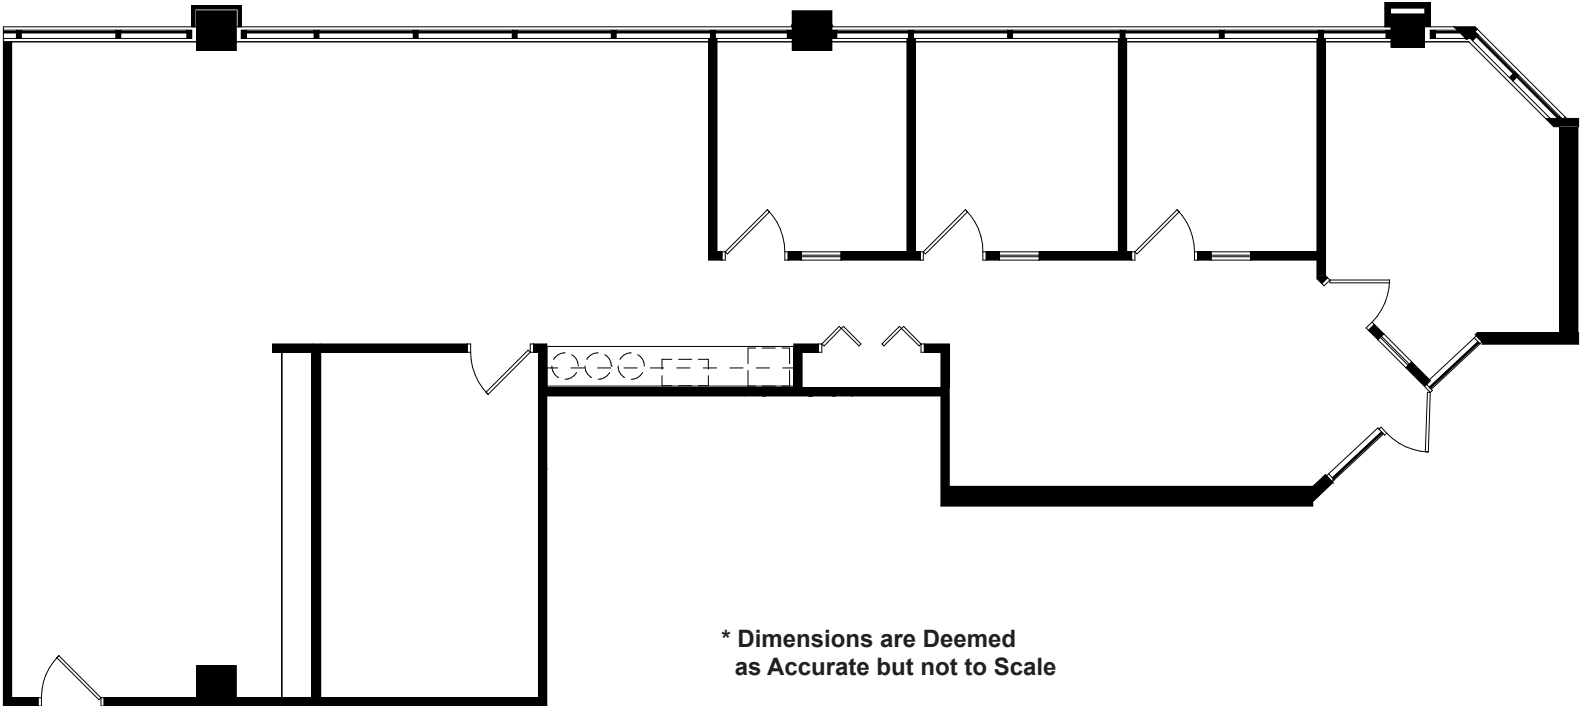

OWNED & MANAGED BY



LEASED BY

