
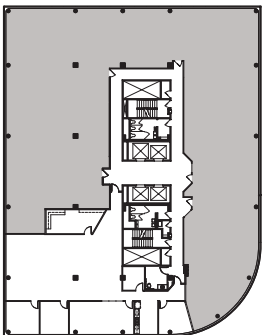


 **BEMISTON TOWER**

Suite 1100

As-Built 3,546 Sq. Ft.

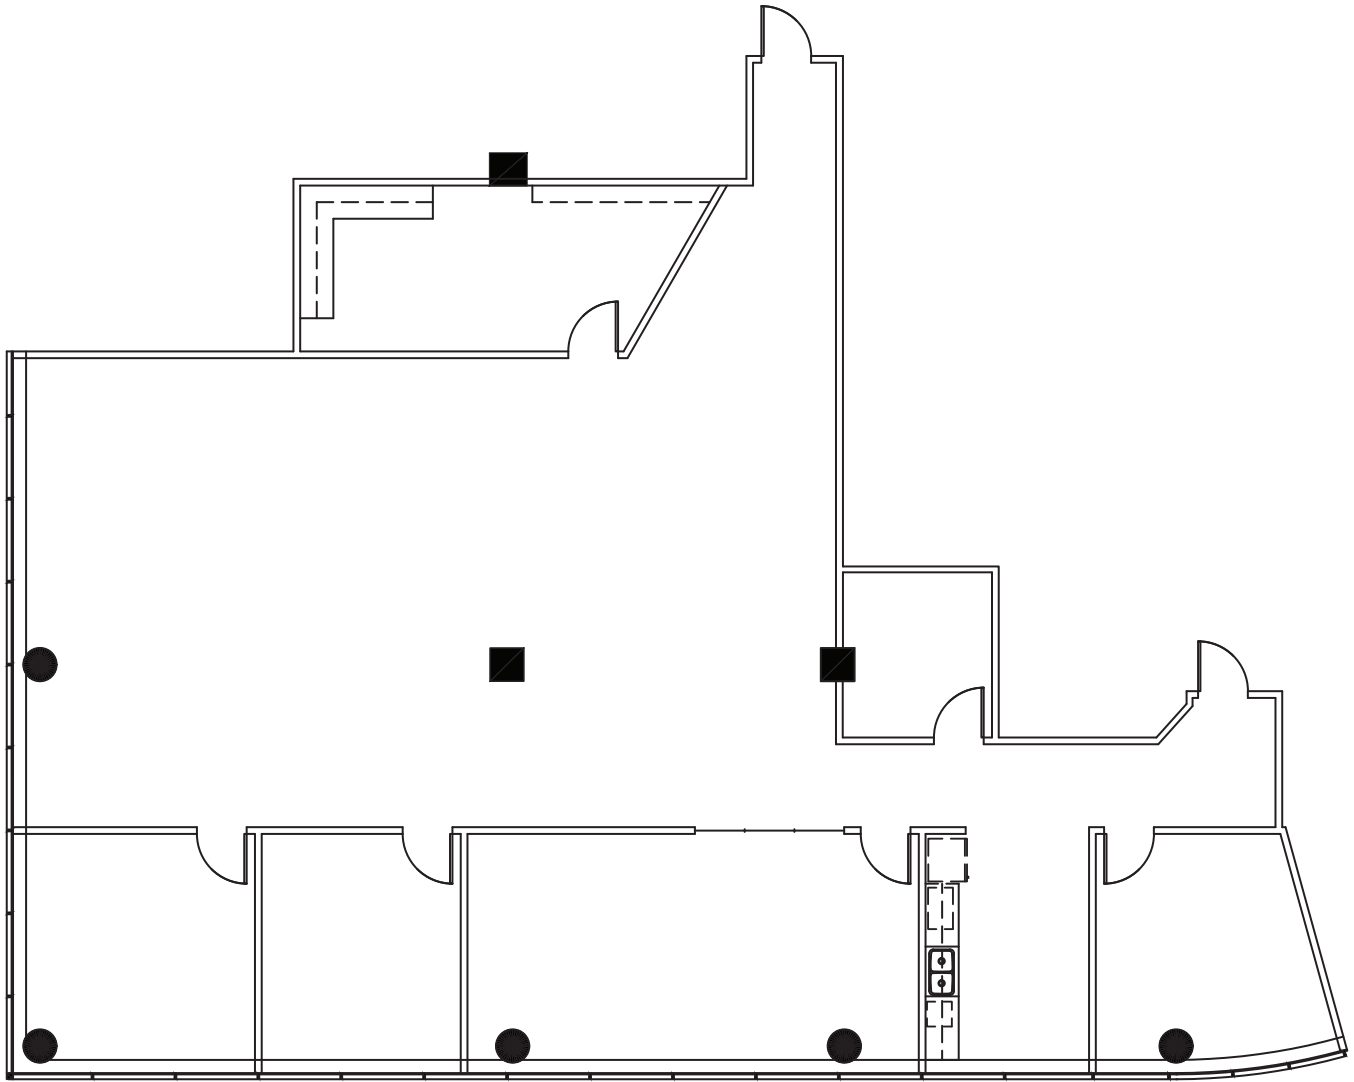

* Dimensions are Deemed as Accurate but not to Scale

LEASED & MANAGED BY

