





BEMISTON TOWER

Suite 1120

As-Built

5,497 Sq. Ft.

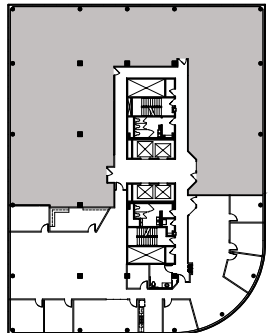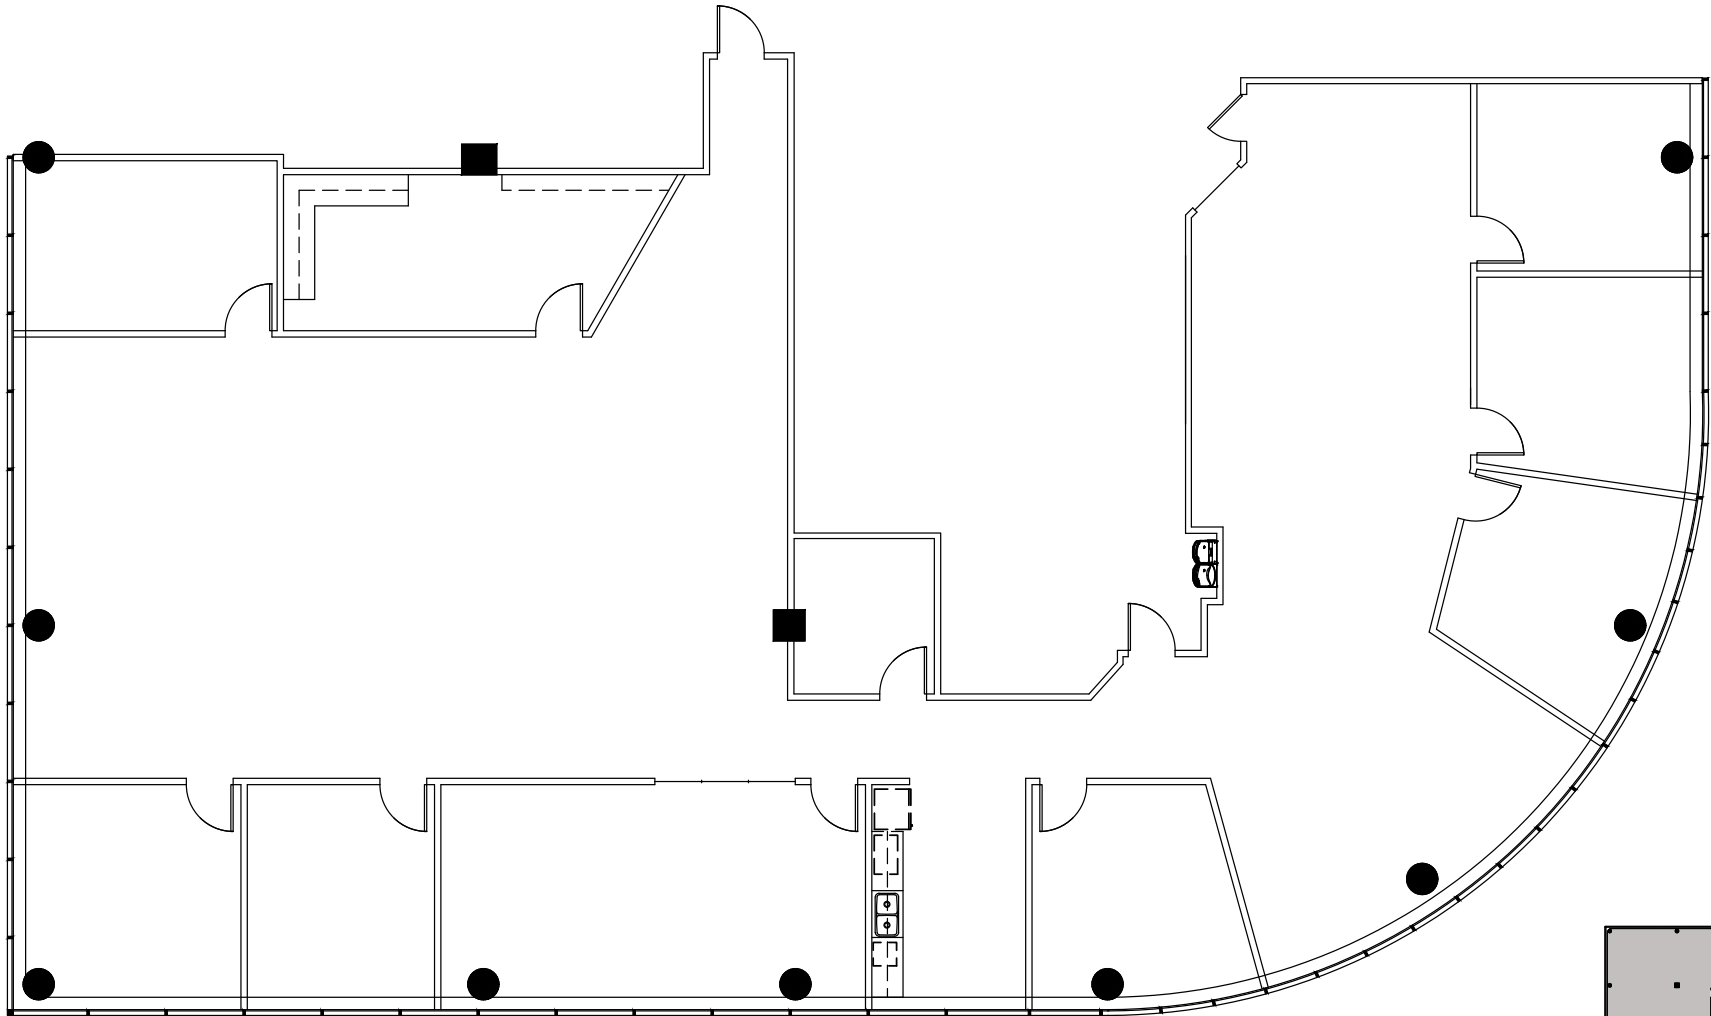

LEASED & MANAGED BY



** Dimensions are Deemed
as Accurate but not to Scale*