




FLAGSHIP


corporate center

Suite 125

As-Built 4,464 Sq. Ft.

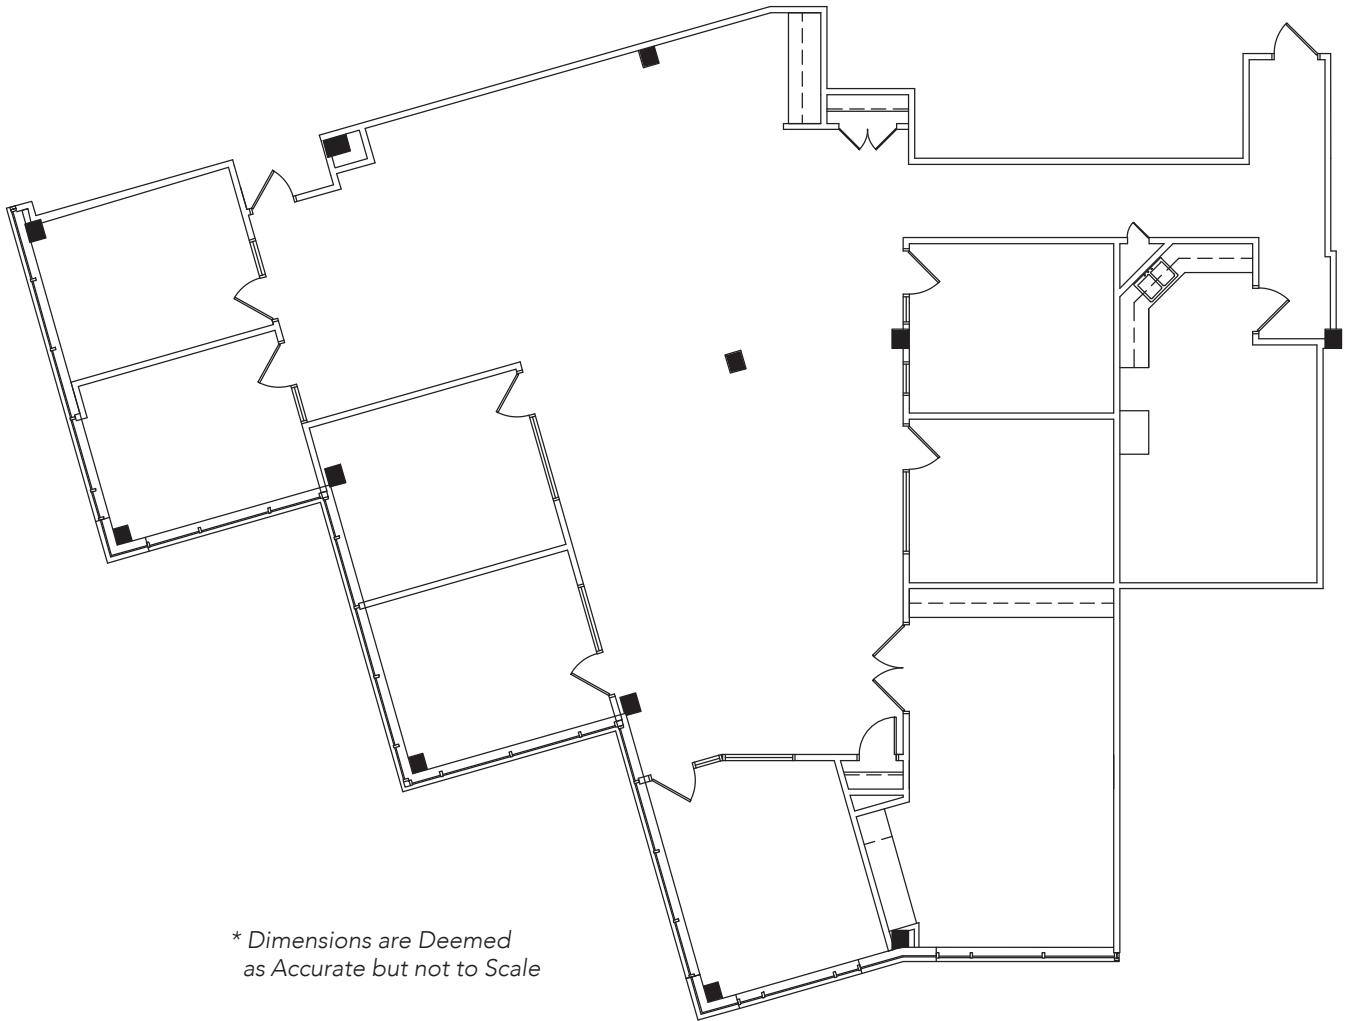

** Dimensions are Deemed
as Accurate but not to Scale*

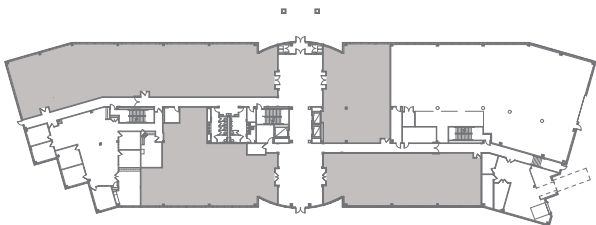

OWNED & MANAGED BY



LEASED BY

