


HIGHLANDS

HIGHLANDS ONE @ FOREST PARK

Suite 160

As-Built 3,367 Sq. Ft.

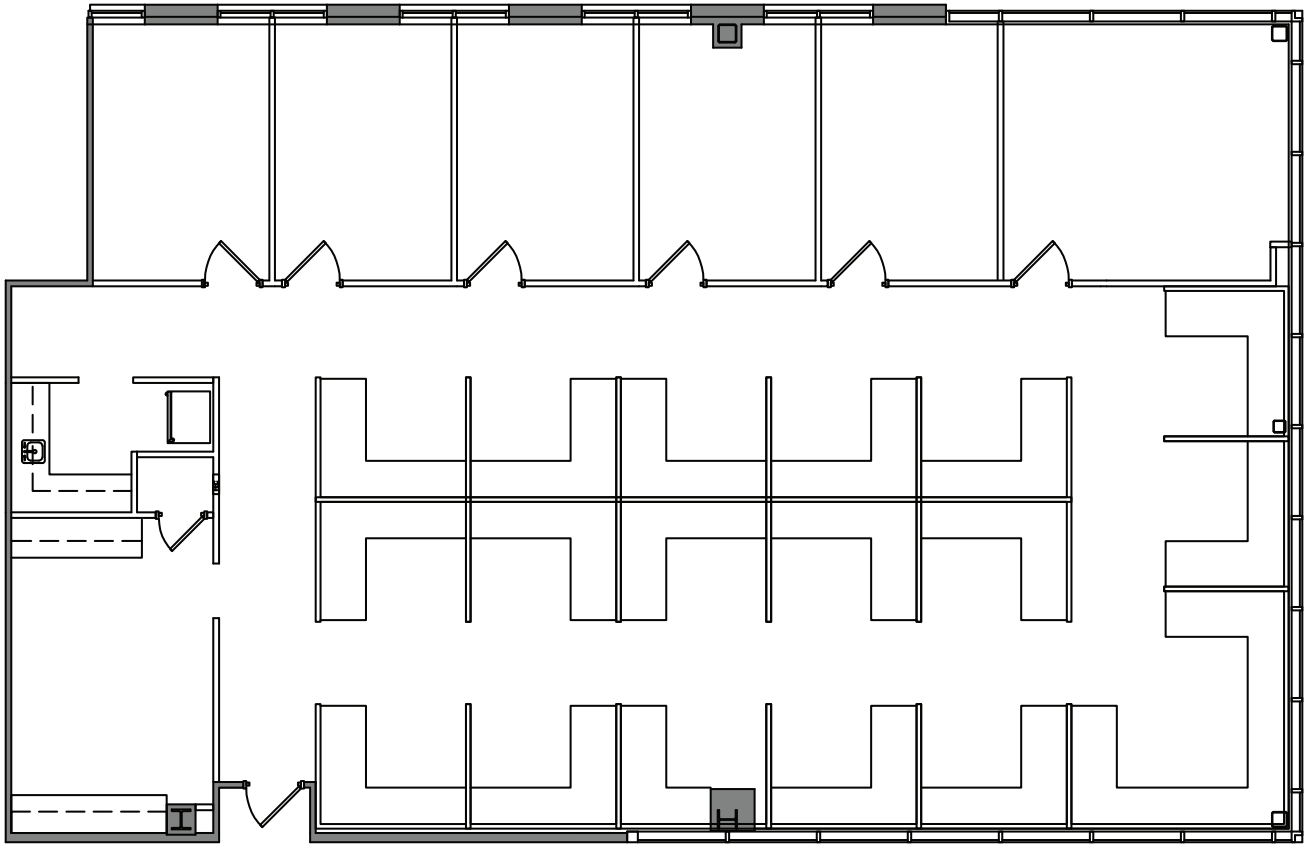

* Dimensions are Deemed as Accurate but not to Scale

LEASED BY

**AVISON
YOUNG**

OWNED & MANAGED BY


ALTUS

