


# MINNESOTA CENTER


Suite 160

As-Built

845 Sq. Ft.

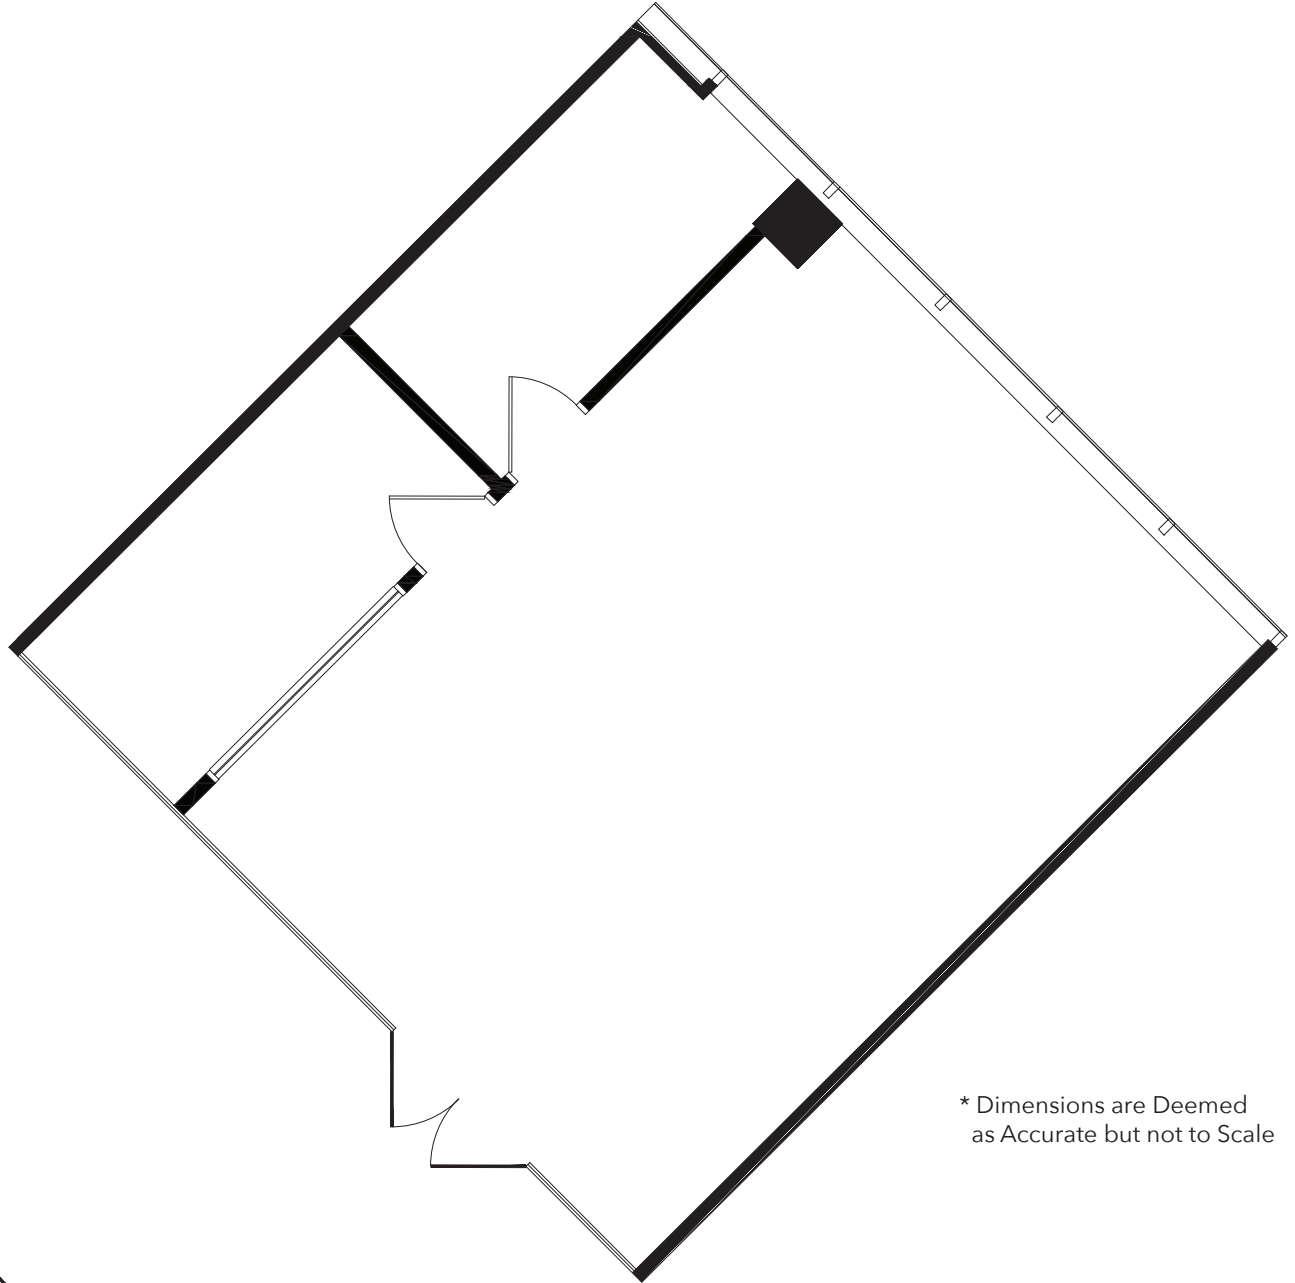

\* Dimensions are Deemed  
as Accurate but not to Scale

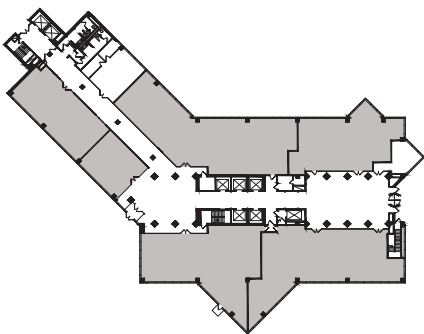

OWNED & MANAGED BY



LEASED BY

