


HIGHLANDS


HIGHLANDS ONE @ FOREST PARK

Suite 160

As-Built 3,367 Sq. Ft.

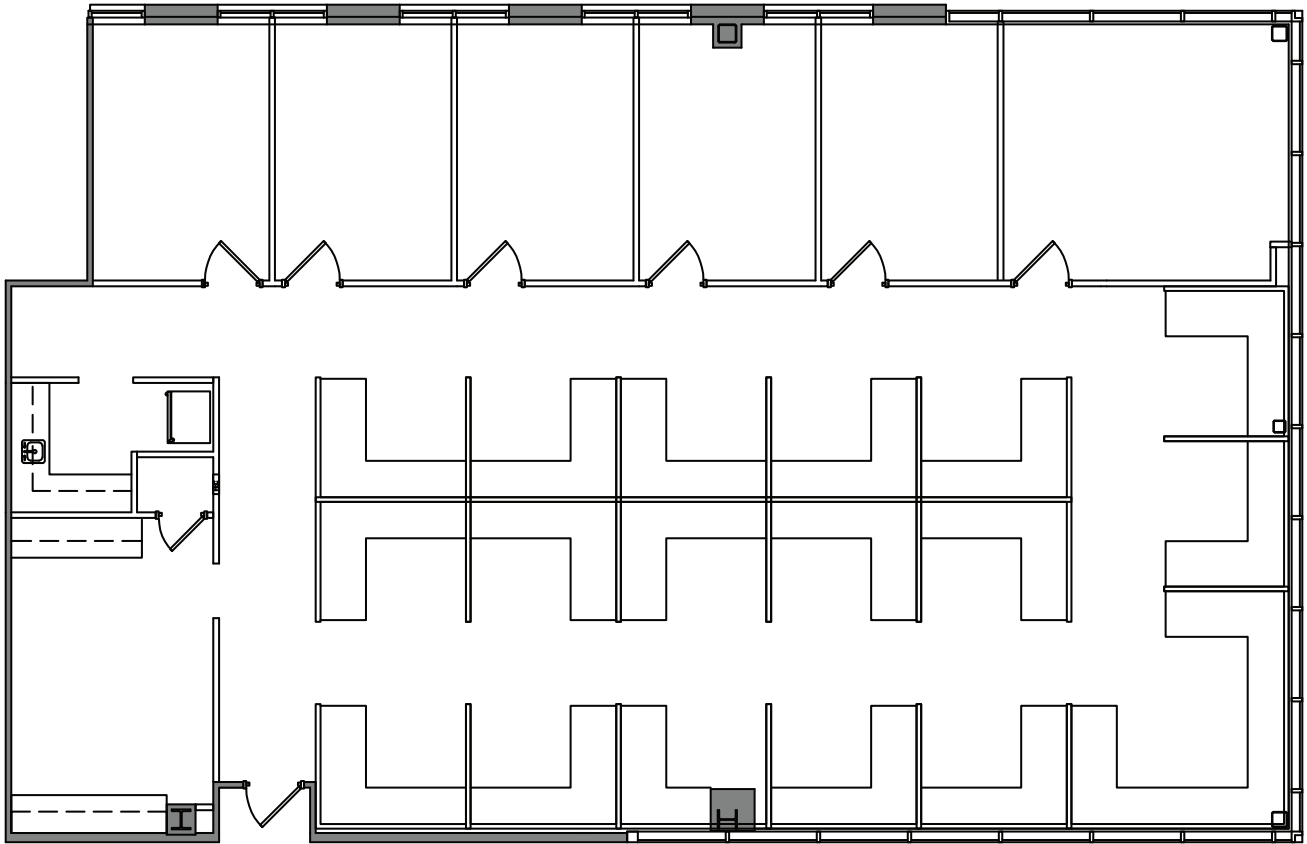

* Dimensions are Deemed as Accurate but not to Scale

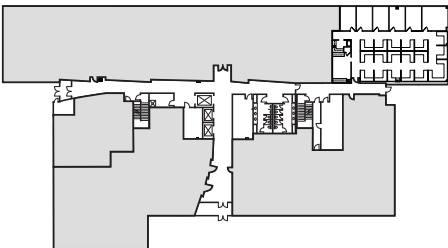

OWNED & MANAGED BY



LEASED BY

