


## Suite 160

As-Built 3,367 Sq. Ft.

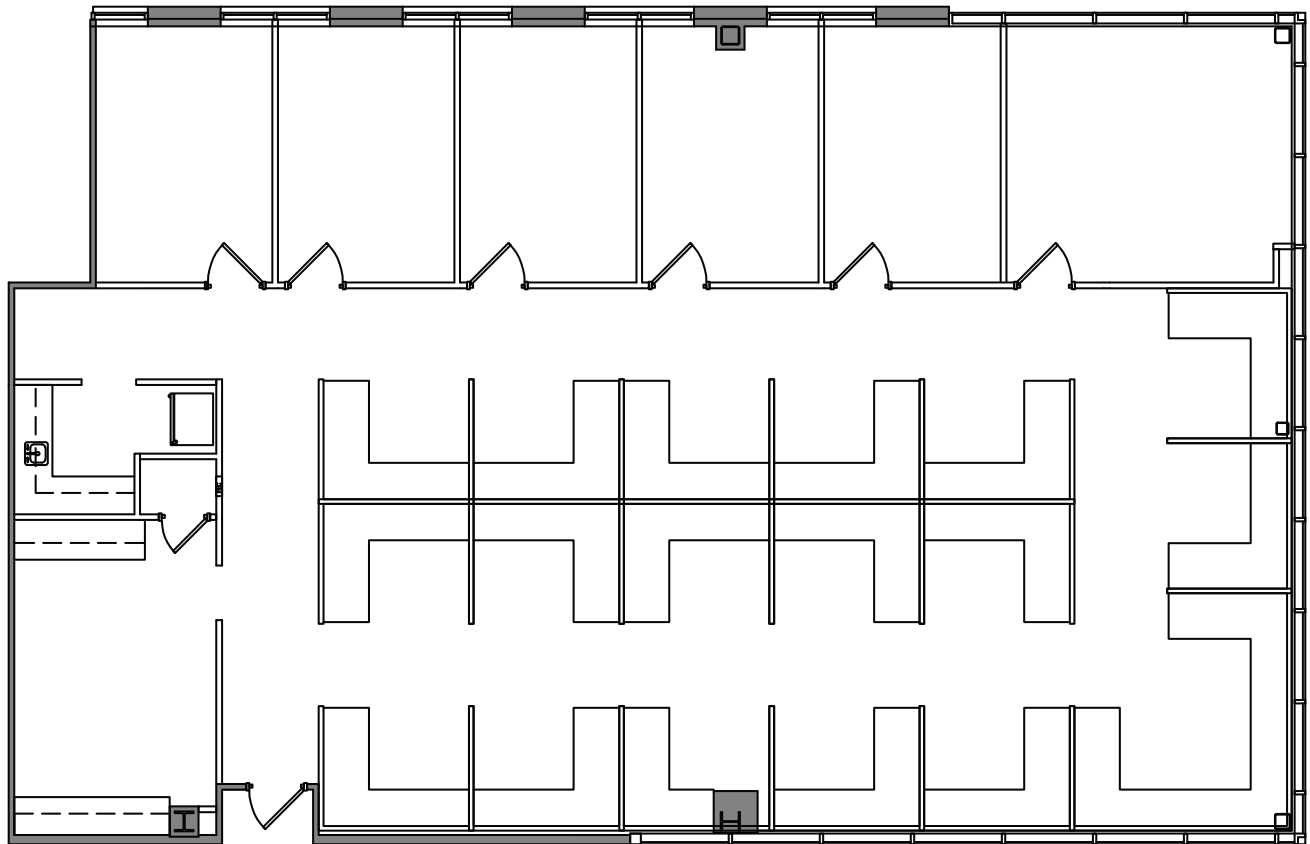

\* Dimensions are Deemed  
as Accurate but not to Scale

LEASED BY

**NEWMARK**  
ZIMMER

OWNED & MANAGED BY

