


# Fenton Industrial

1601 & 1603 Manufacturers Drive

As-Built 8,551 Sq. Ft.

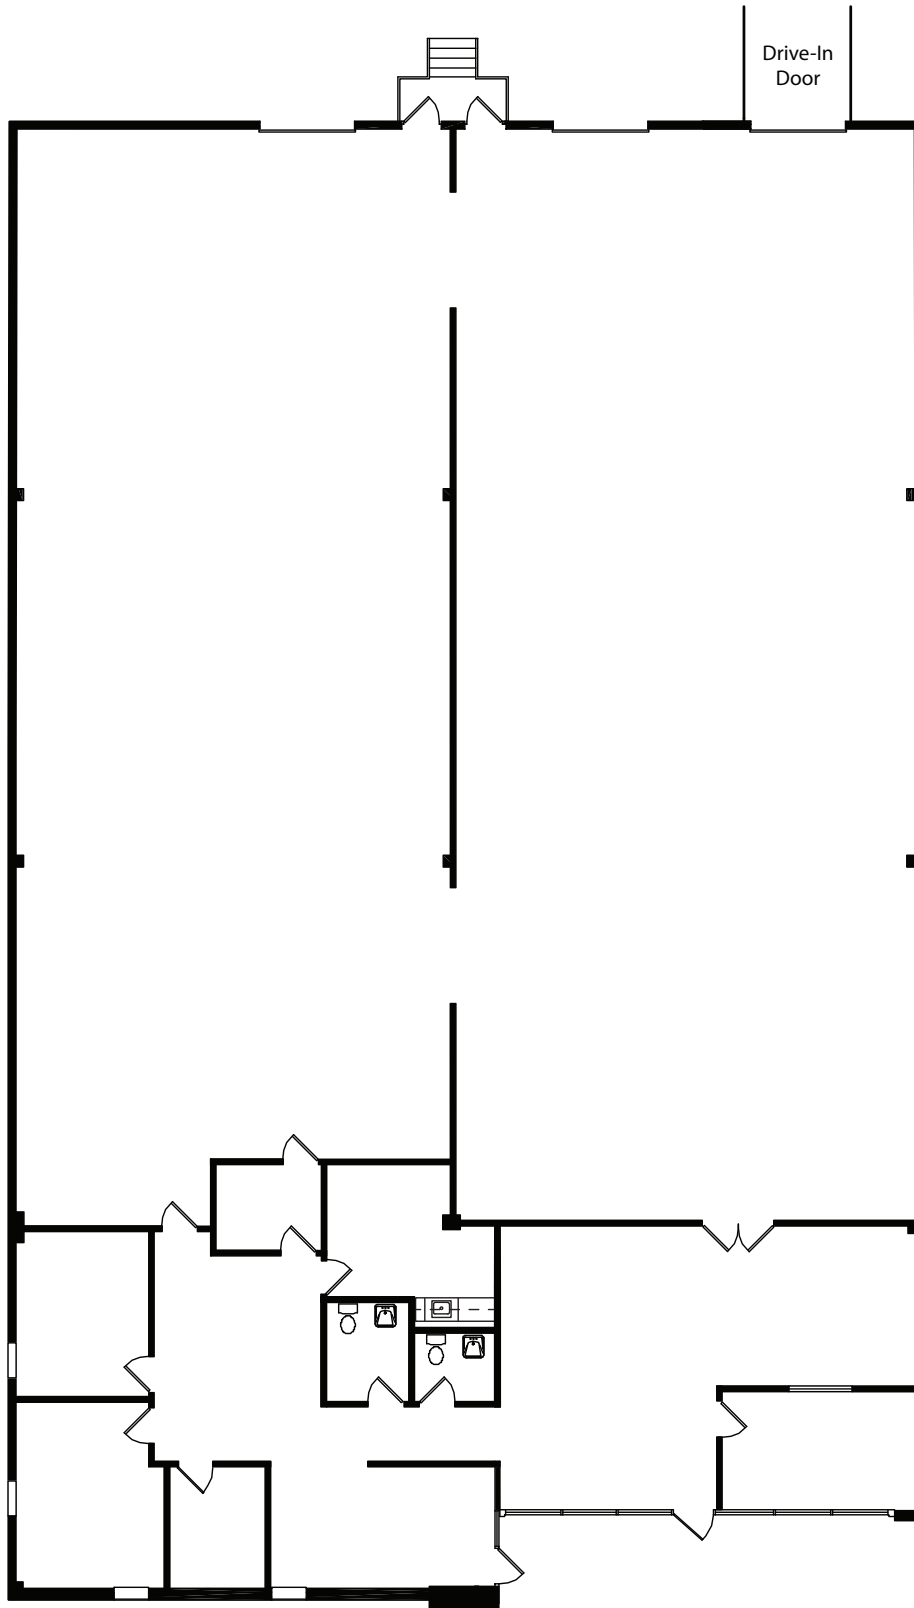

\* Dimensions are Deemed as Accurate but not to Scale

