



# Chesterfield Crossing

1657 Clarkson Road

As-Built 2,988 Sq. Ft.

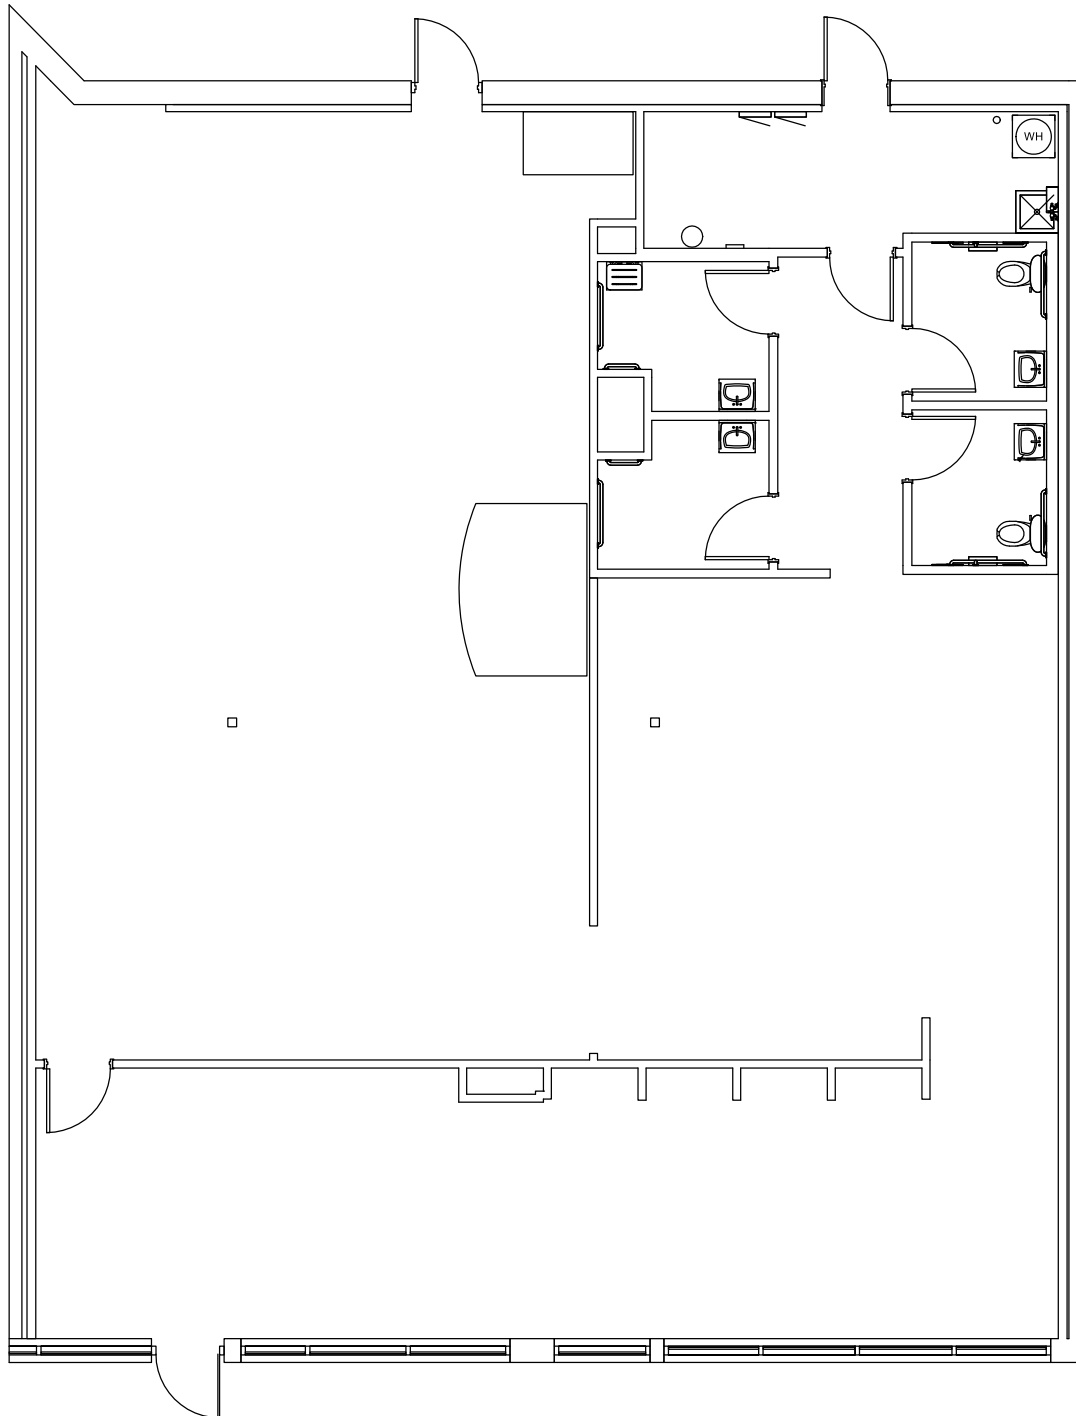

*\* Dimensions are Deemed  
as Accurate but not to Scale*

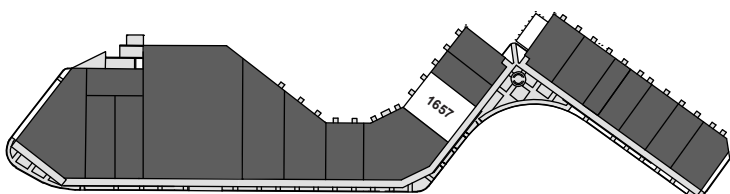

OWNED & MANAGED BY



LEASED BY

