



Chesterfield Crossing

1657 Clarkson Road

As-Built 2,988 Sq. Ft.

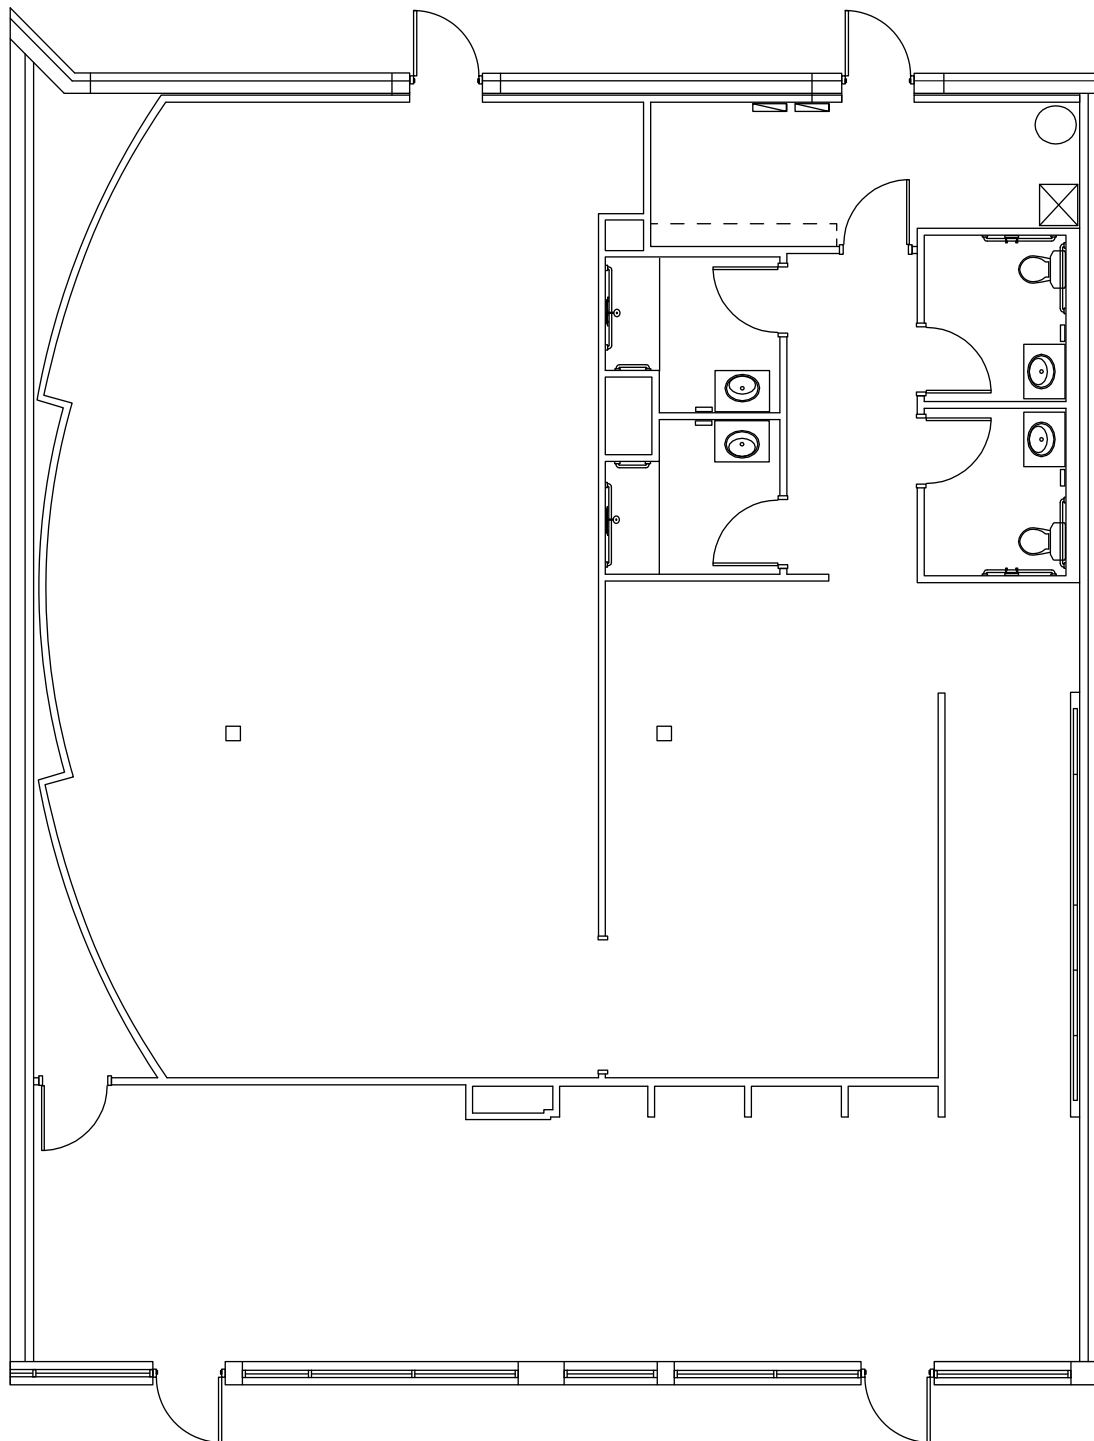

** Dimensions are Deemed
as Accurate but not to Scale*

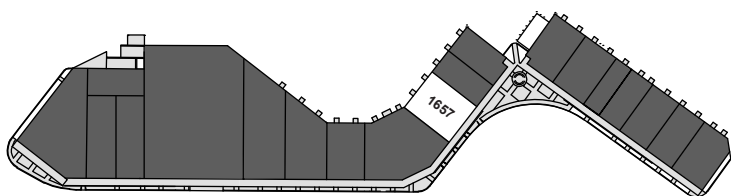

OWNED & MANAGED BY



LEASED BY

