



Chesterfield Crossing

1671 Clarkson Road

As-Built 2,400 Sq. Ft.

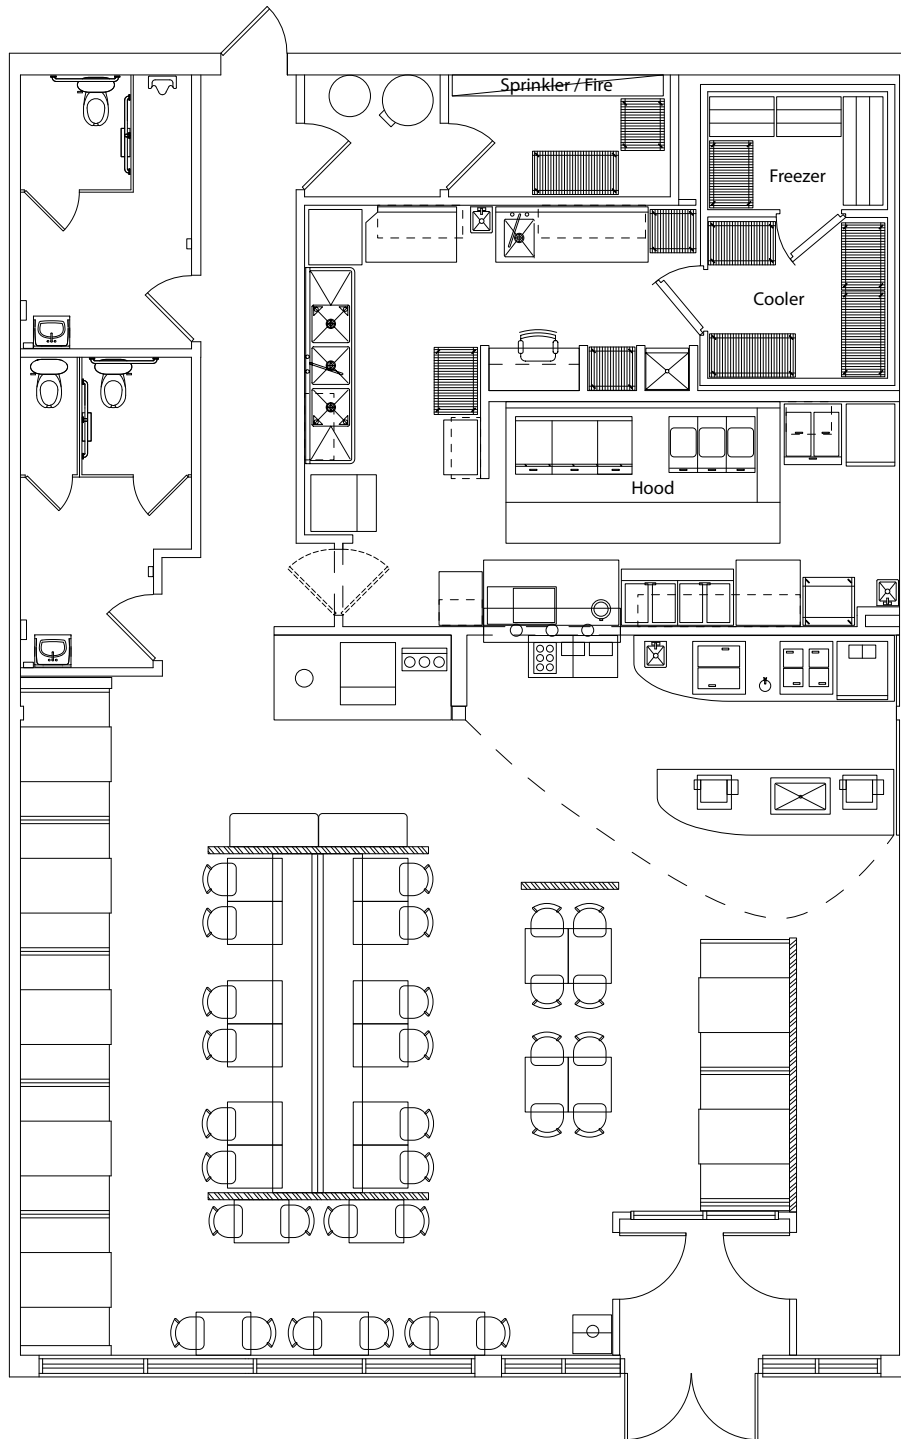

** Dimensions are Deemed as Accurate but not to Scale*

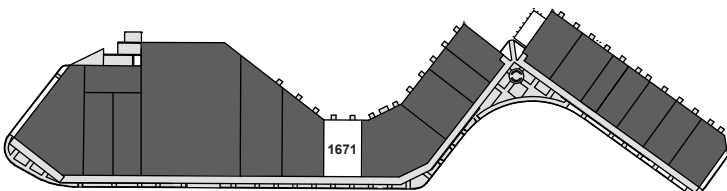

OWNED & MANAGED BY



LEASED BY

