


# CIBC PLACE

Suite 170

As-Built 2,623 Sq. Ft.

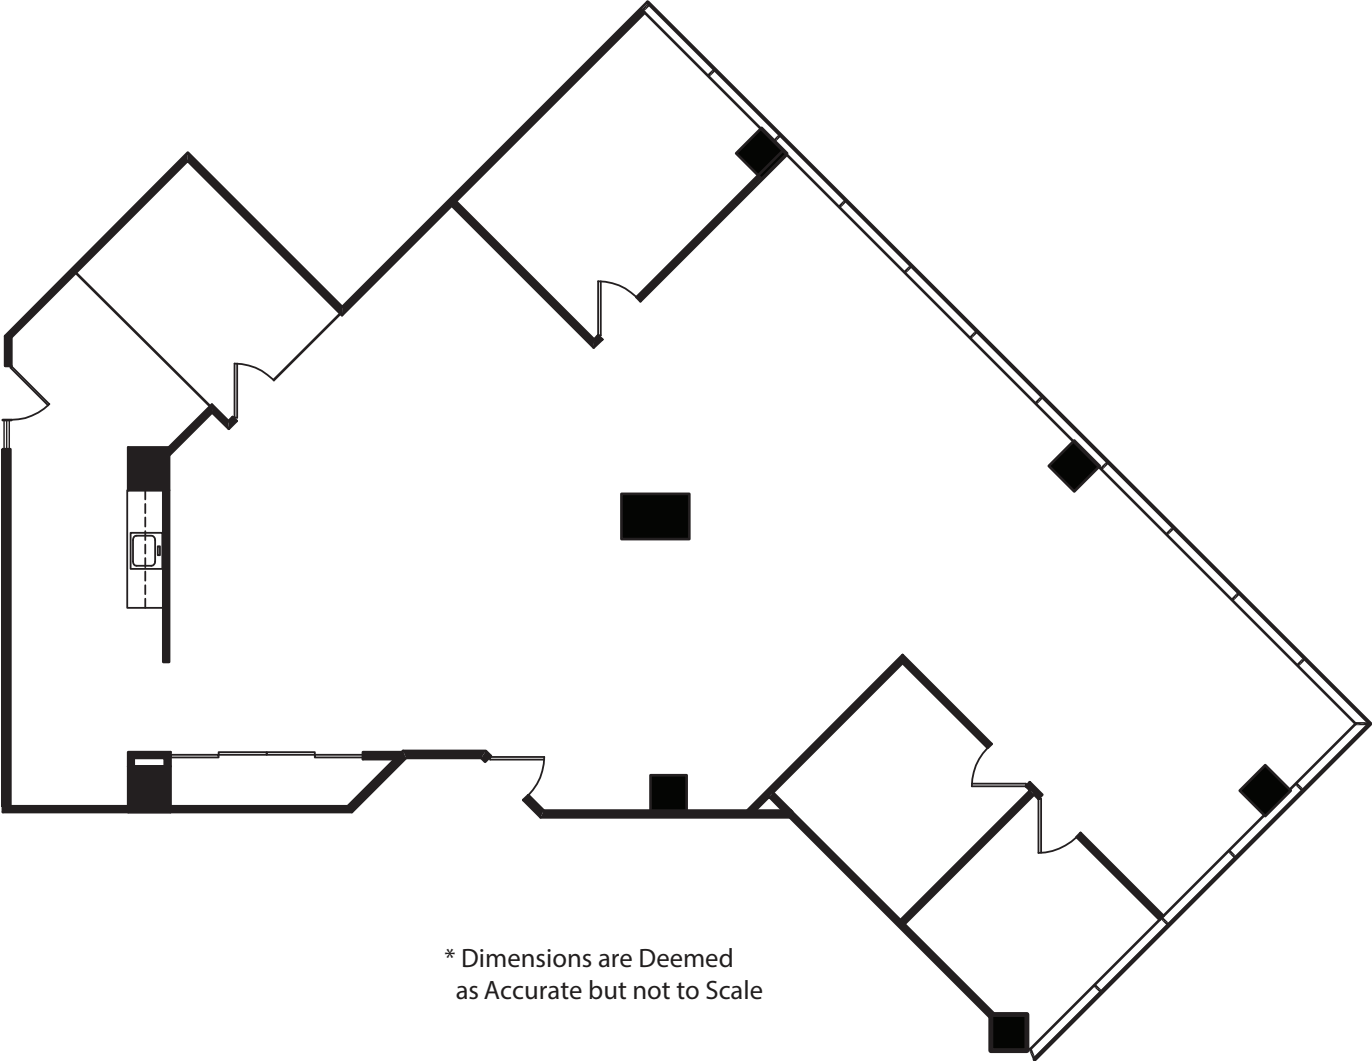

\* Dimensions are Deemed as Accurate but not to Scale

