



Suite 170

As-Built      5,322 Sq. Ft.

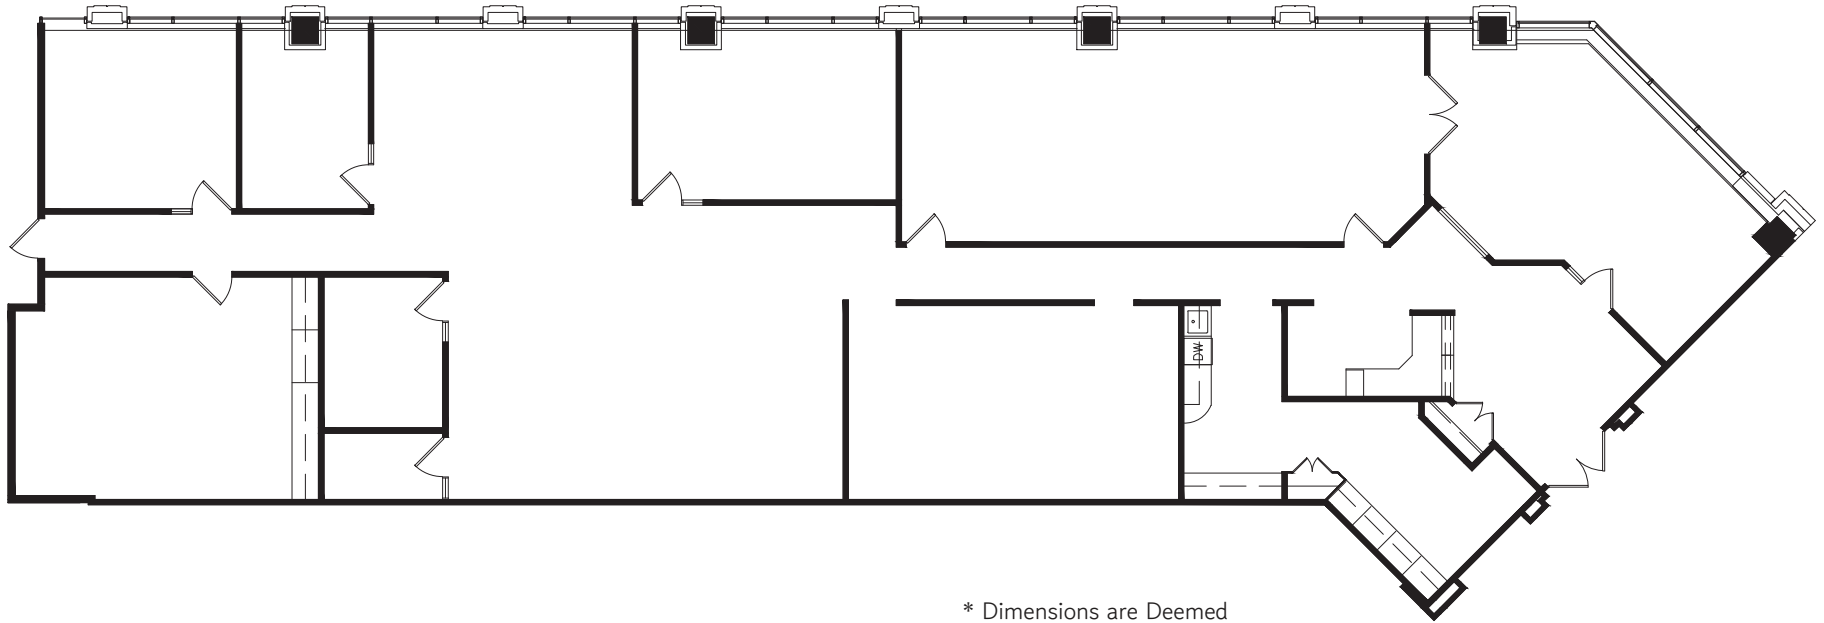

\* Dimensions are Deemed  
as Accurate but not to Scale

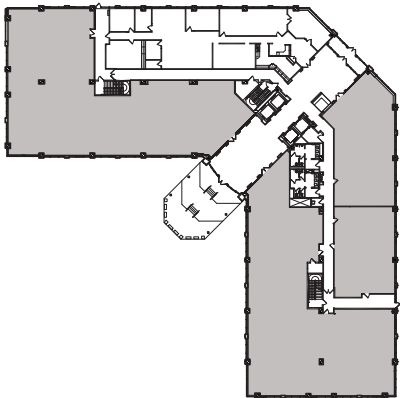

OWNED & MANAGED BY



LEASED BY

