





BROADWAY EAST

Suite 180

As-Built 913 Sq. Ft.

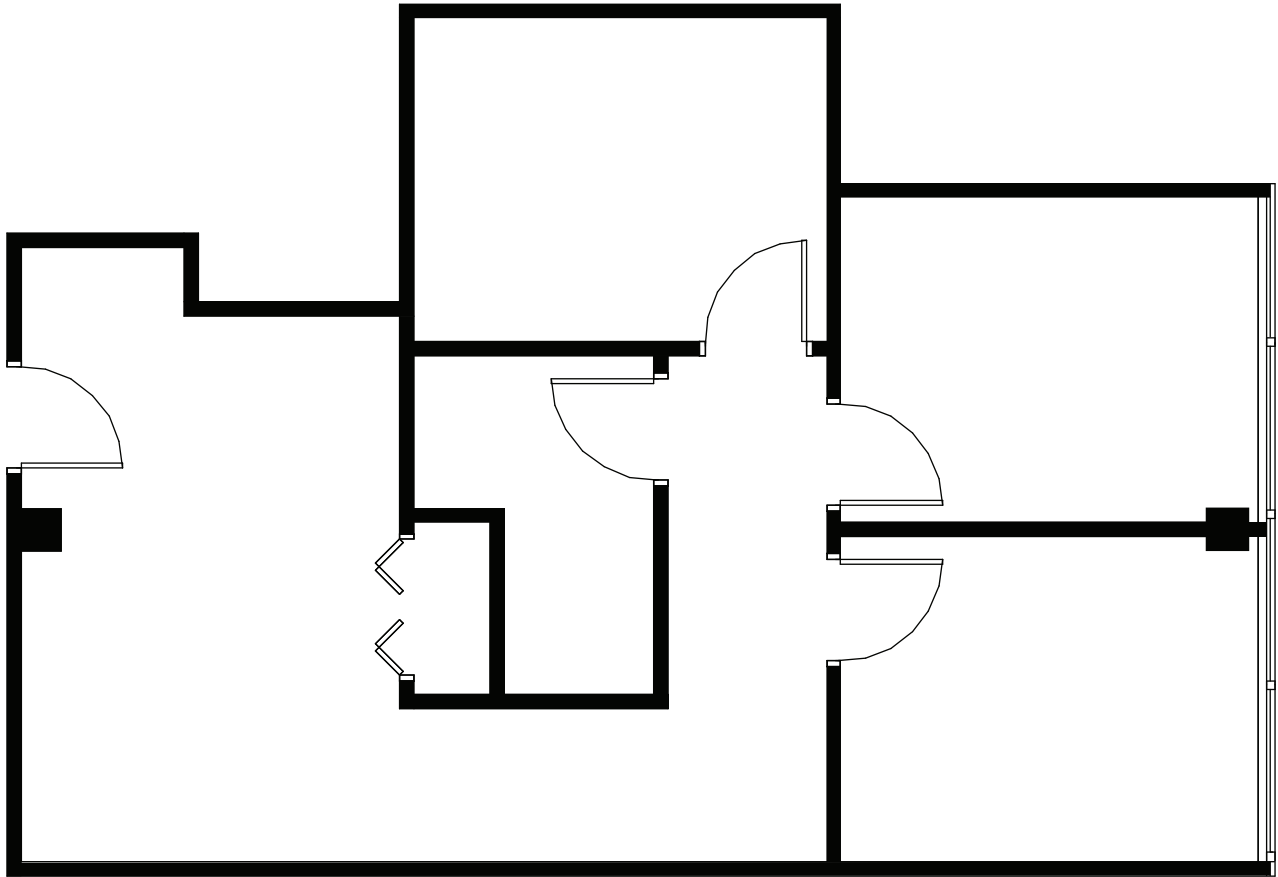

* Dimensions are Deemed
as Accurate but not to Scale

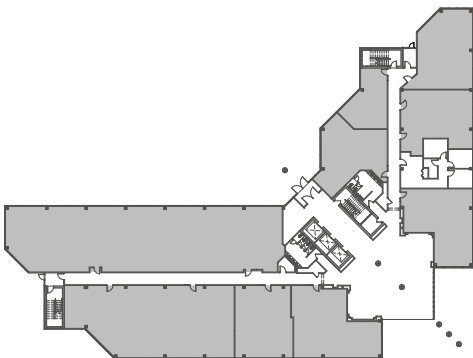

OWNED & MANAGED BY



LEASED BY

