



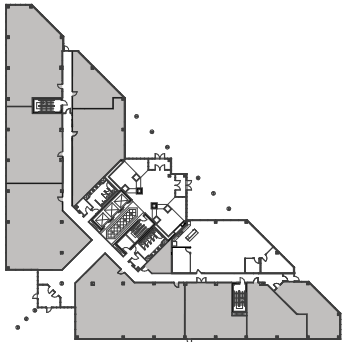

# BROADWAY WEST

Suite 1950

As-Built      2,575 Sq. Ft.

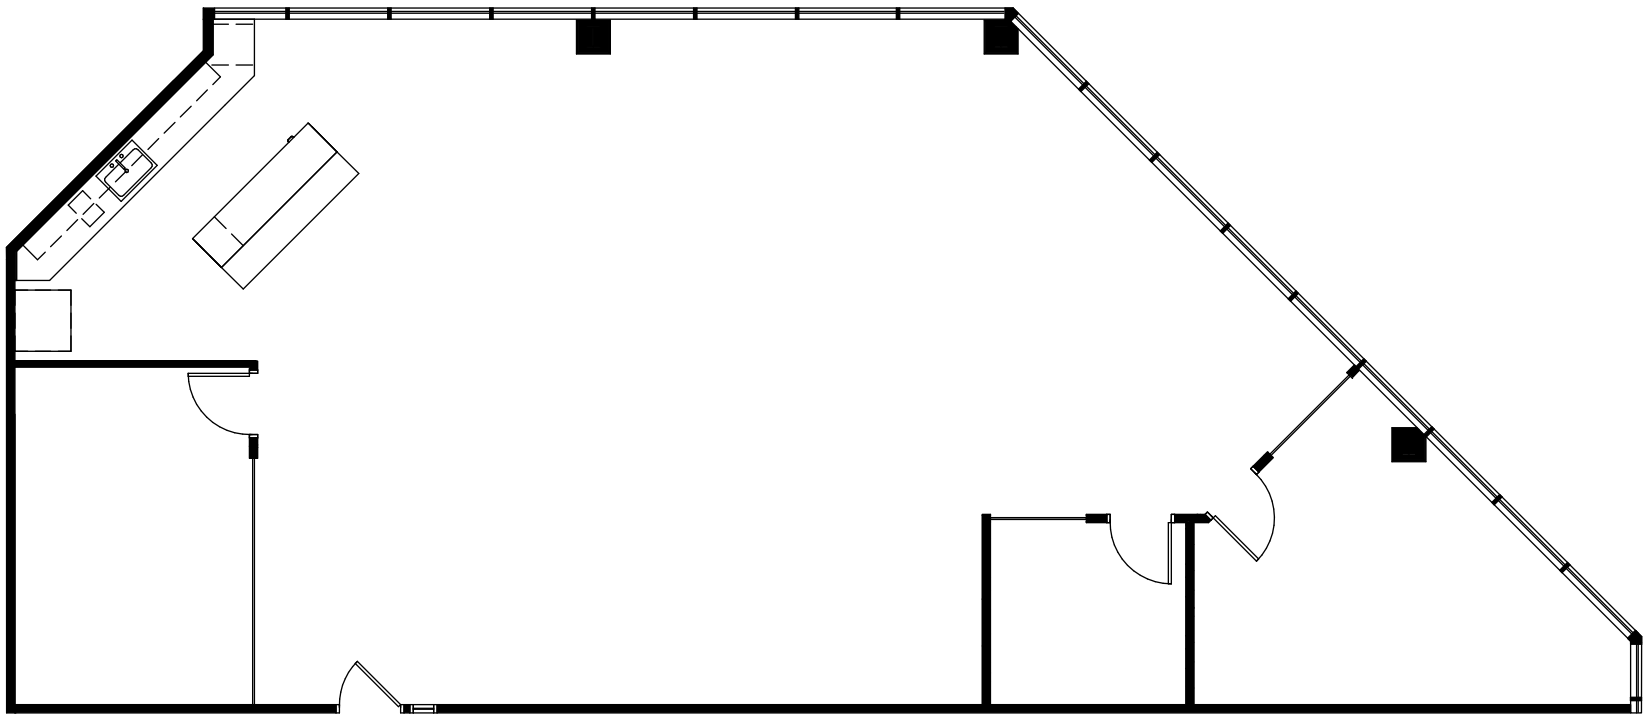

\* Dimensions are Deemed  
as Accurate but not to Scale

OWNED & MANAGED BY



LEASED BY

