
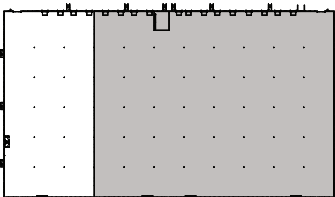


ZACHARY

DISTRIBUTION CENTER

Suite 200

As-Built 47,112 Sq. Ft.

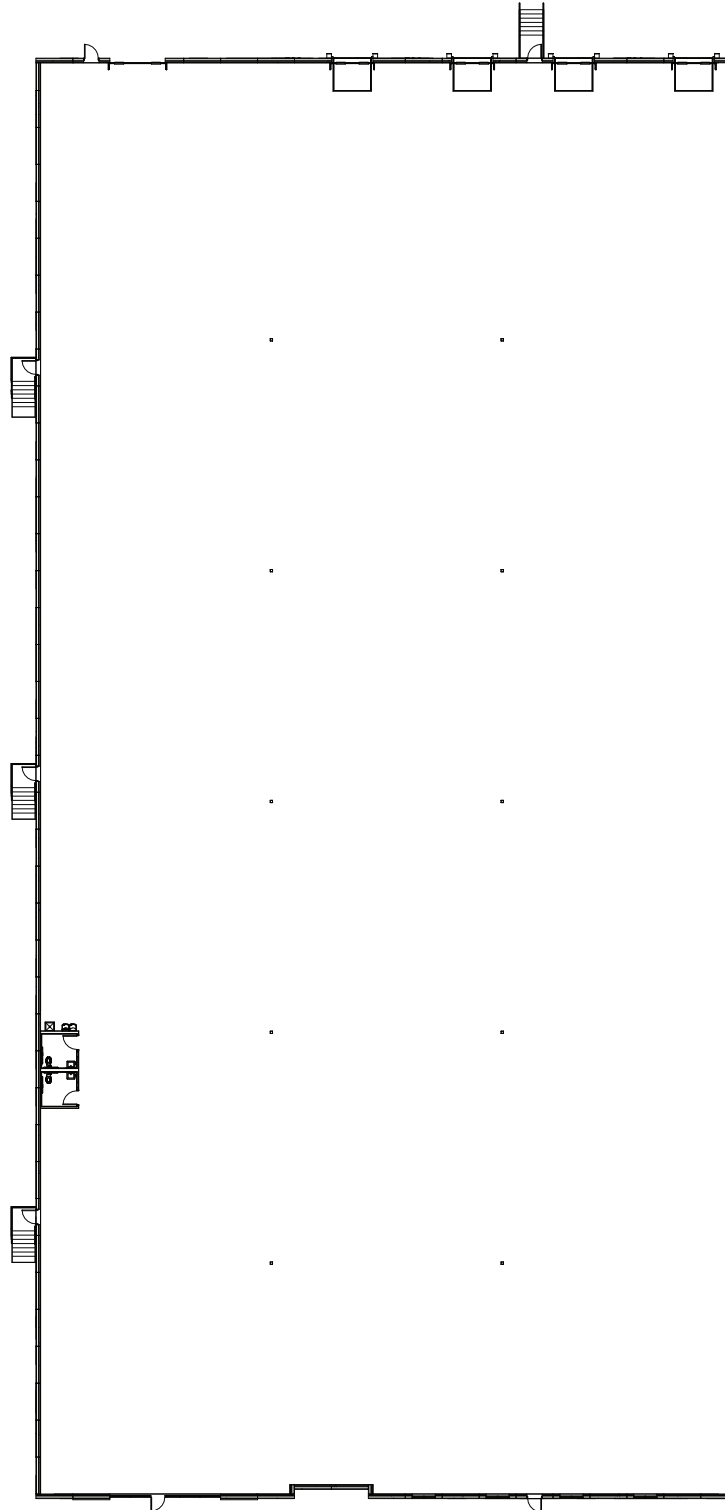

** Dimensions are Deemed as Accurate but not to Scale*

OWNED BY



LEASED BY

