


HIGHLANDS

HIGHLANDS ONE @ FOREST PARK

Suite 200

As-Built 24,767 Sq. Ft.

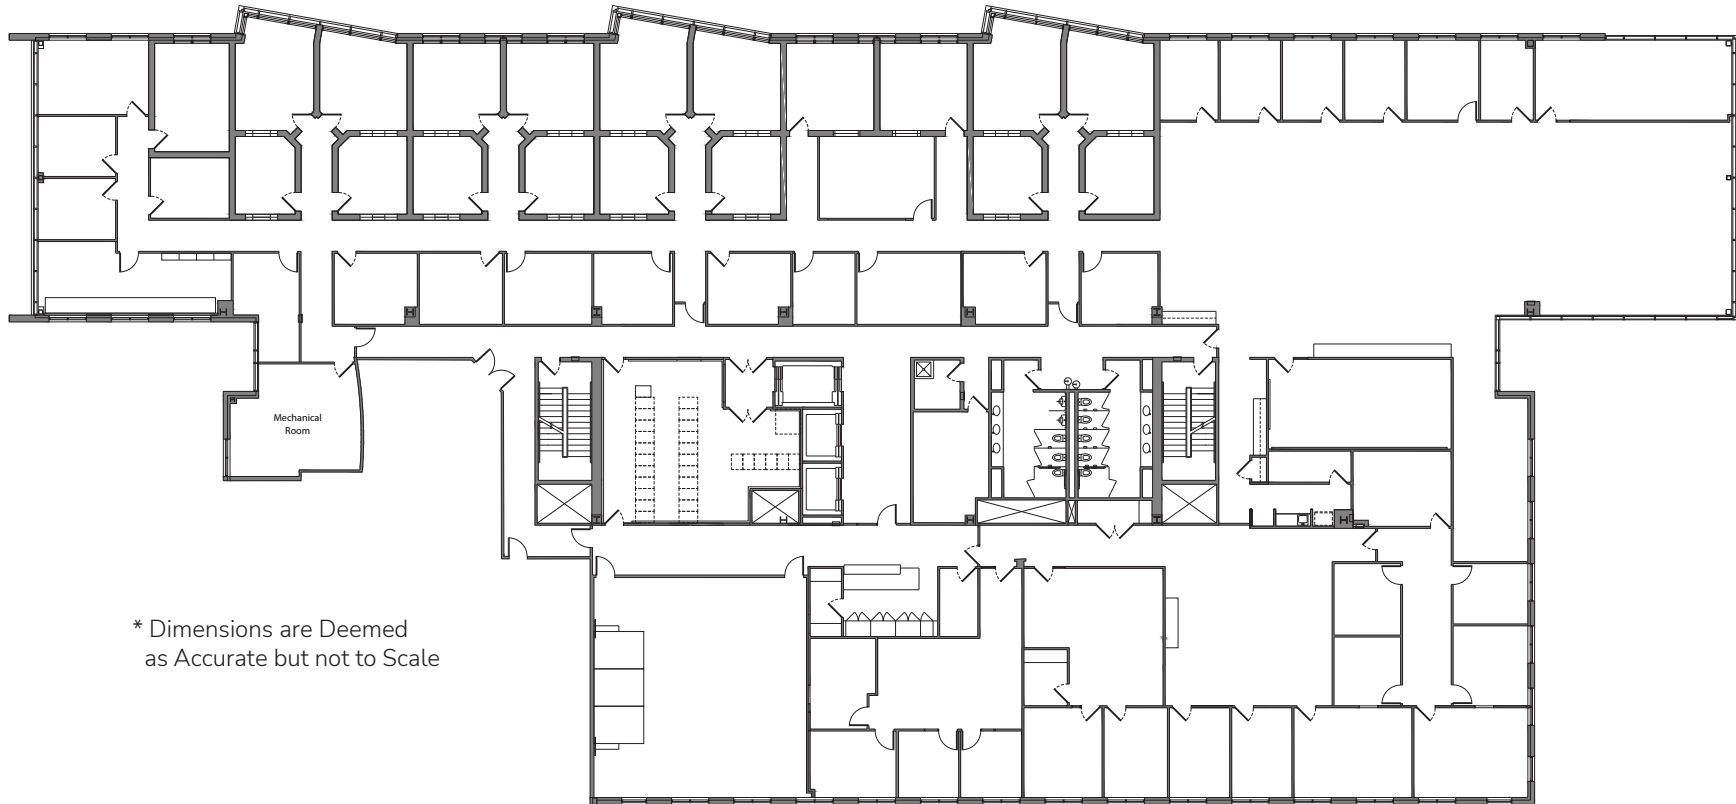

* Dimensions are Deemed as Accurate but not to Scale

LEASED BY

NEWMARK
ZIMMER

OWNED & MANAGED BY

