


HIGHLANDS

HIGHLANDS ONE @ FOREST PARK

Suite 200

As-Built 24,767 Sq. Ft.

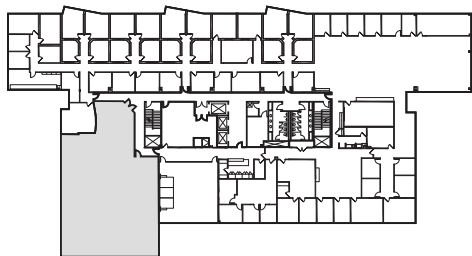

OWNED & MANAGED BY



LEASED BY

