


HIGHLANDS


HIGHLANDS ONE @ FOREST PARK

Suite 200

As-Built 24,767 Sq. Ft.

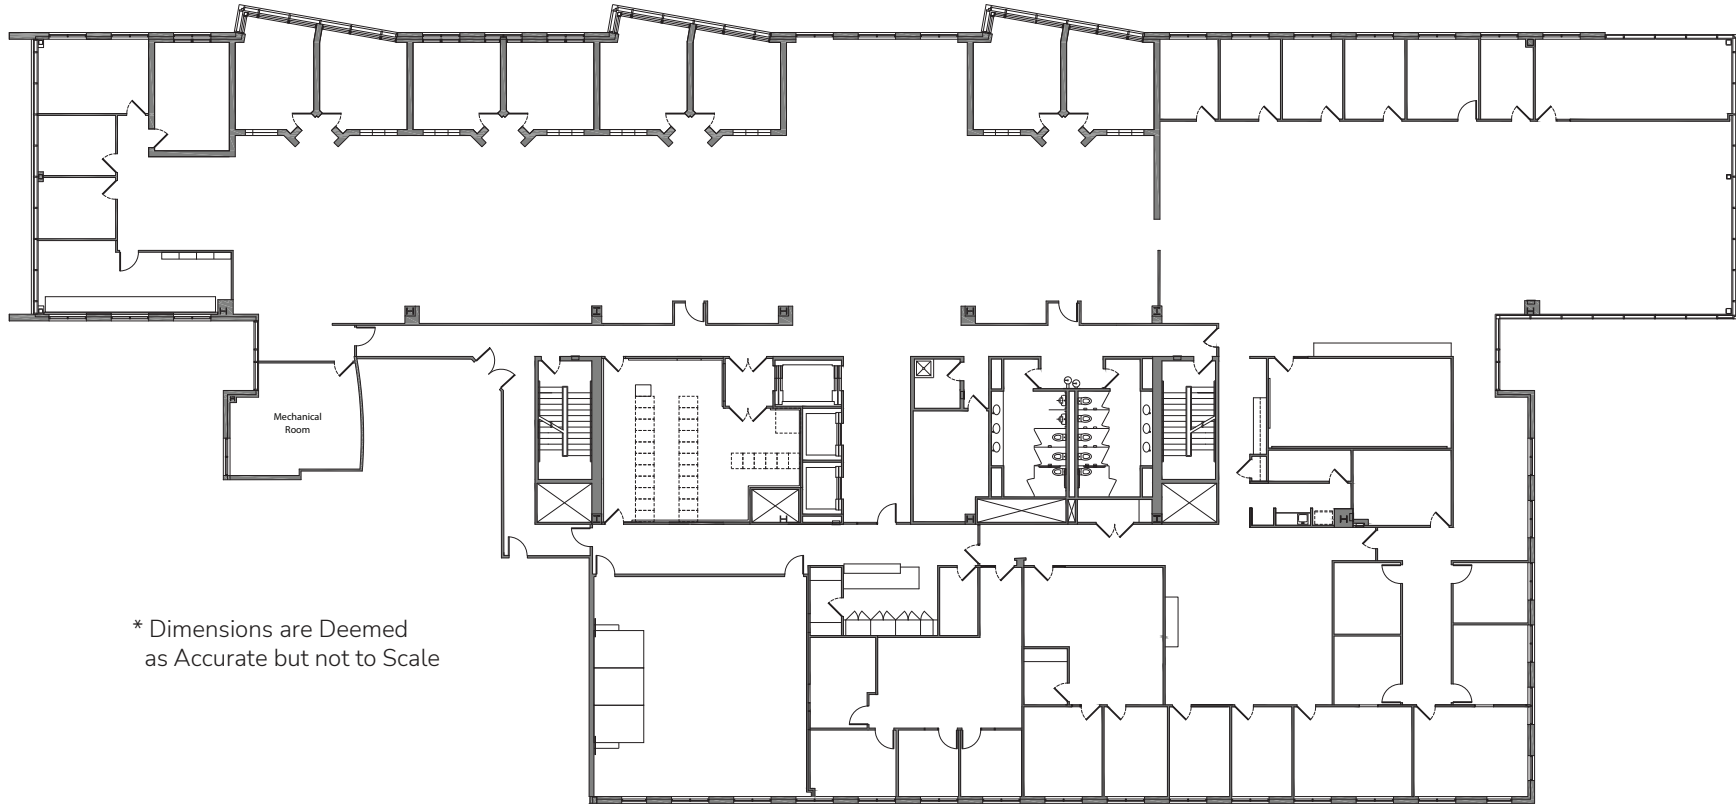

* Dimensions are Deemed as Accurate but not to Scale

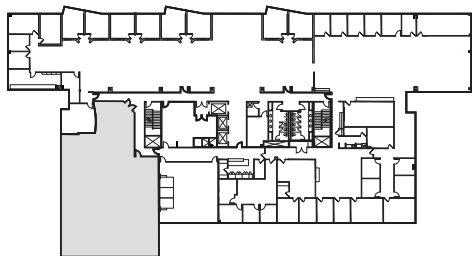

OWNED & MANAGED BY



LEASED BY

