


EDINBOROUGH


CORPORATE CENTER

Suite 204

As-Built 972 Sq. Ft.

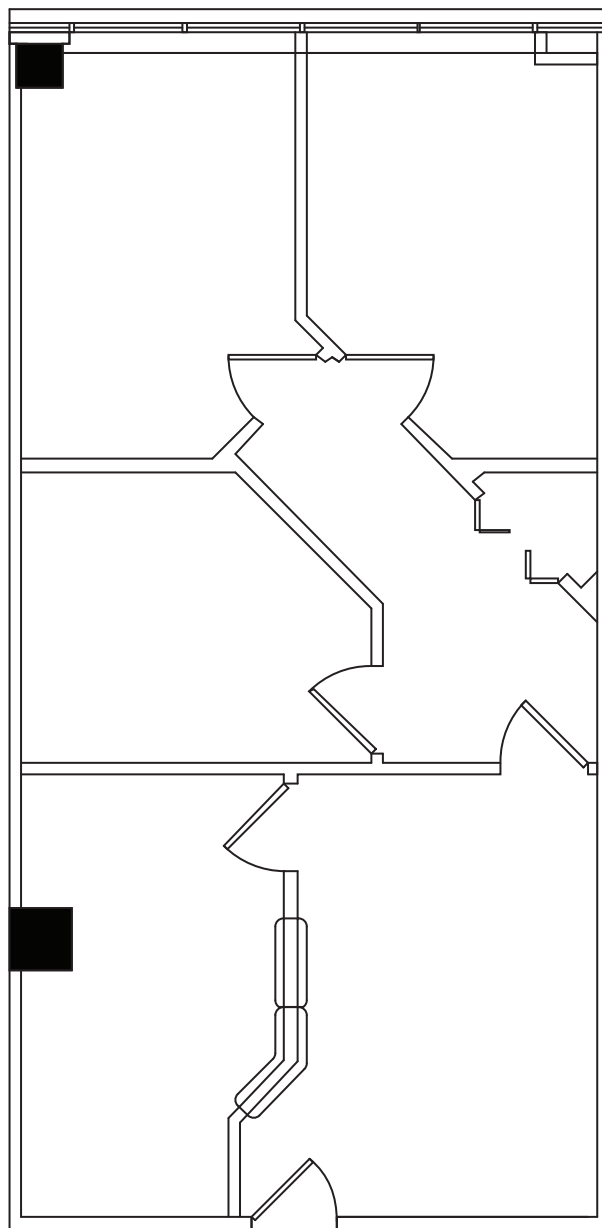

* Dimensions are Deemed as Accurate but not to Scale

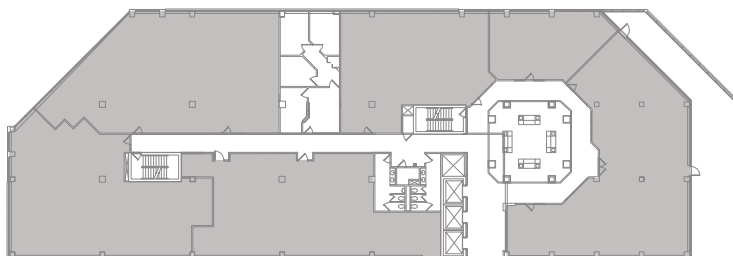

OWNED & MANAGED BY



LEASED BY

