



# OLYMPIC PLACE

Suite 210

As-Built 3,088 Sq. Ft.

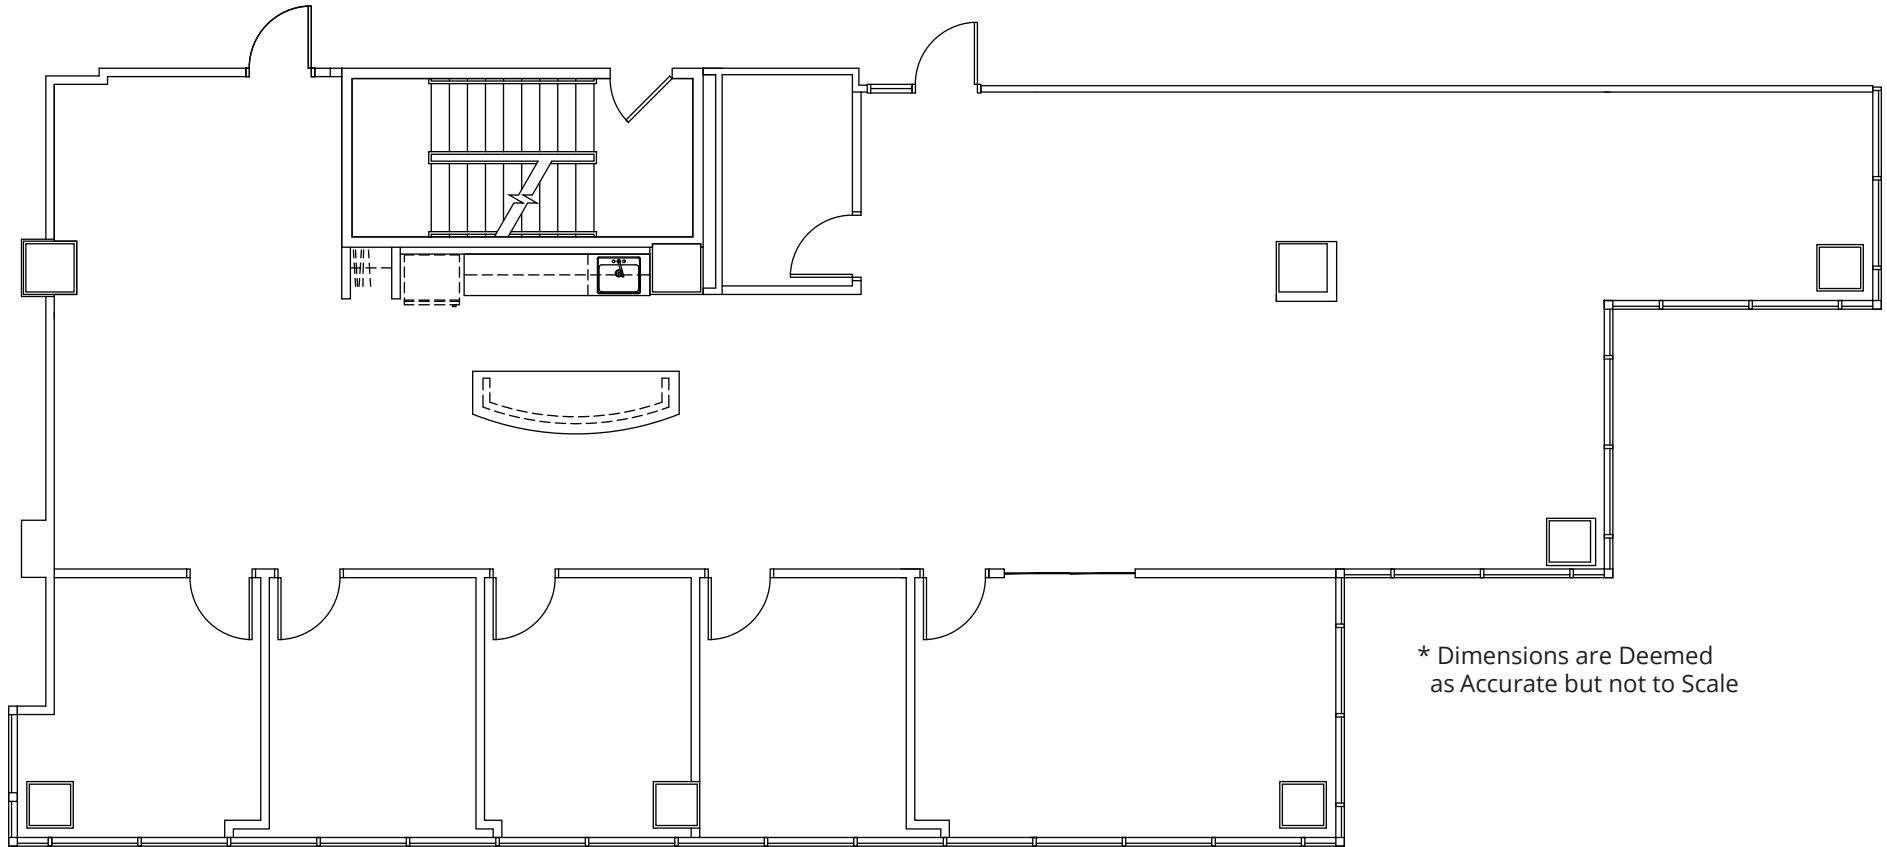

\* Dimensions are Deemed as Accurate but not to Scale

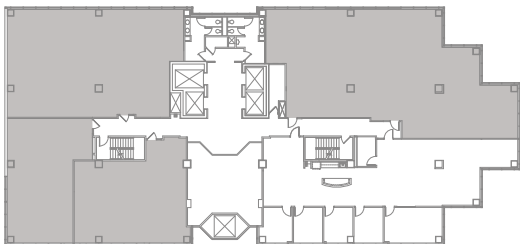

OWNED & MANAGED BY



LEASED BY

