



OLYMPIC PLACE

Suite 225

As-Built 1,338 Sq. Ft.

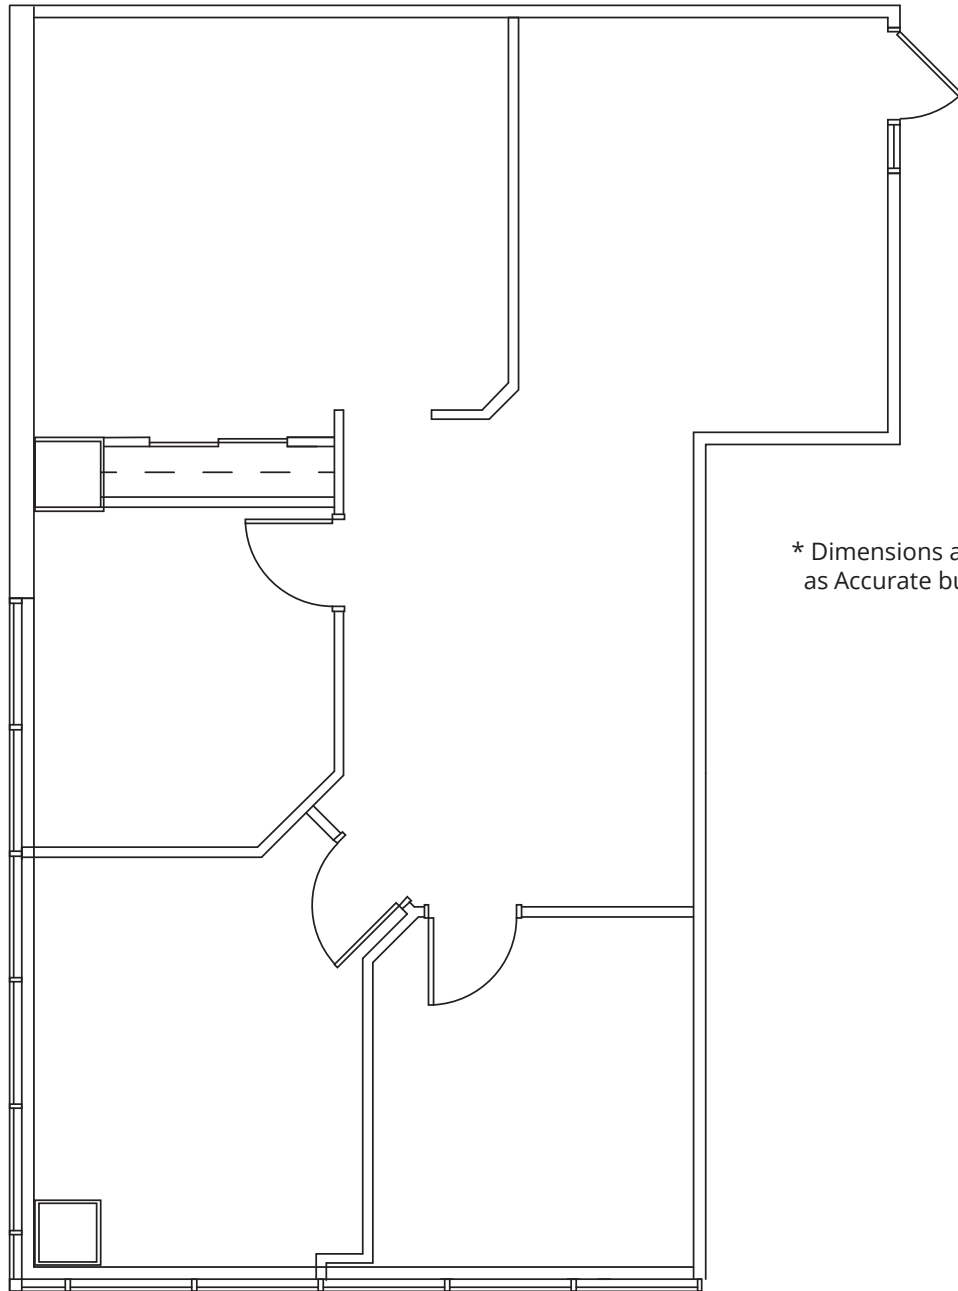

* Dimensions are Deemed
as Accurate but not to Scale

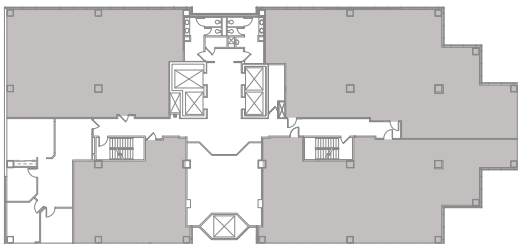

OWNED & MANAGED BY



LEASED BY

