


# HIGHLANDS

HIGHLANDS ONE @ FOREST PARK

## Suite 250

As-Built

4,914 Sq. Ft.

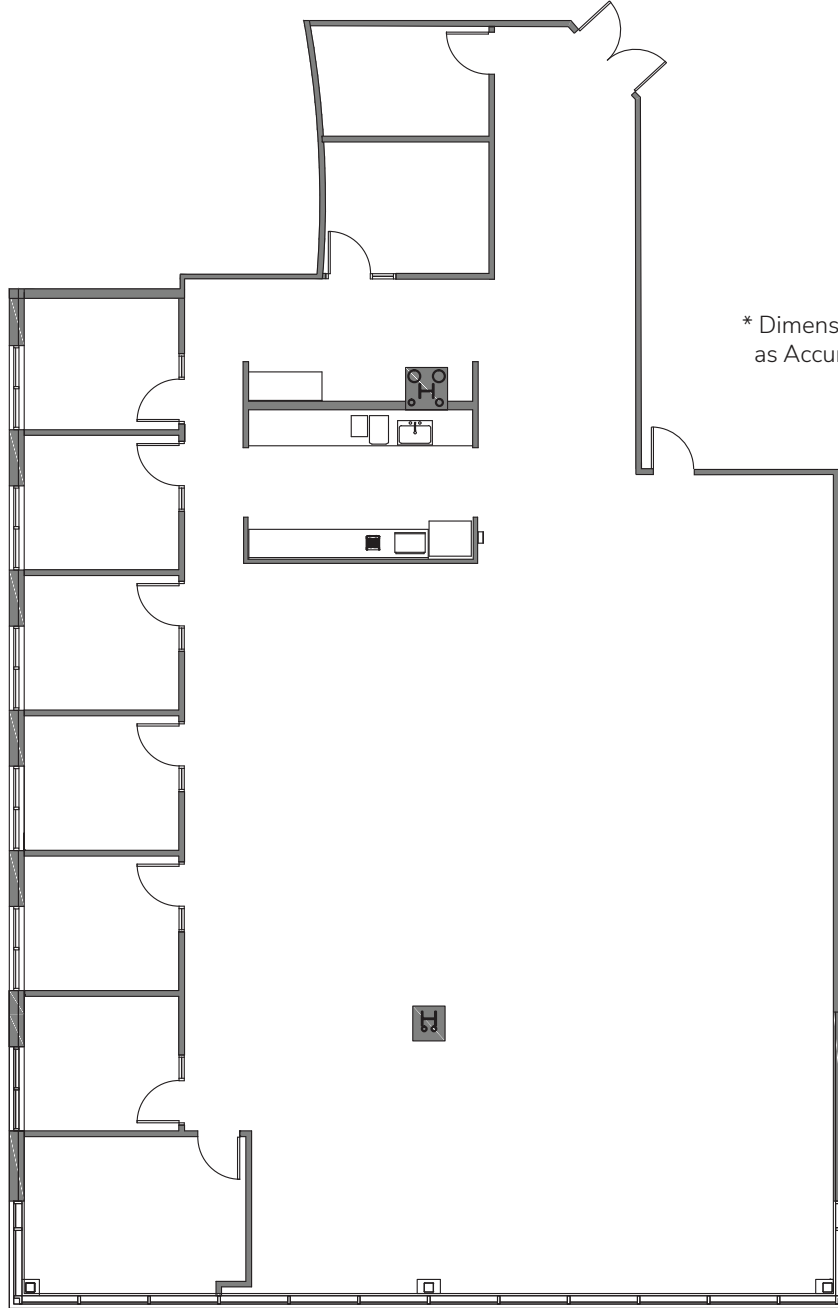

\* Dimensions are Deemed as Accurate but not to Scale

LEASED BY

**AVISON  
YOUNG**

OWNED & MANAGED BY

  
**ALTUS**

