



BEMISTON TOWER

Suite 250

As-Built 1,101 Sq. Ft.

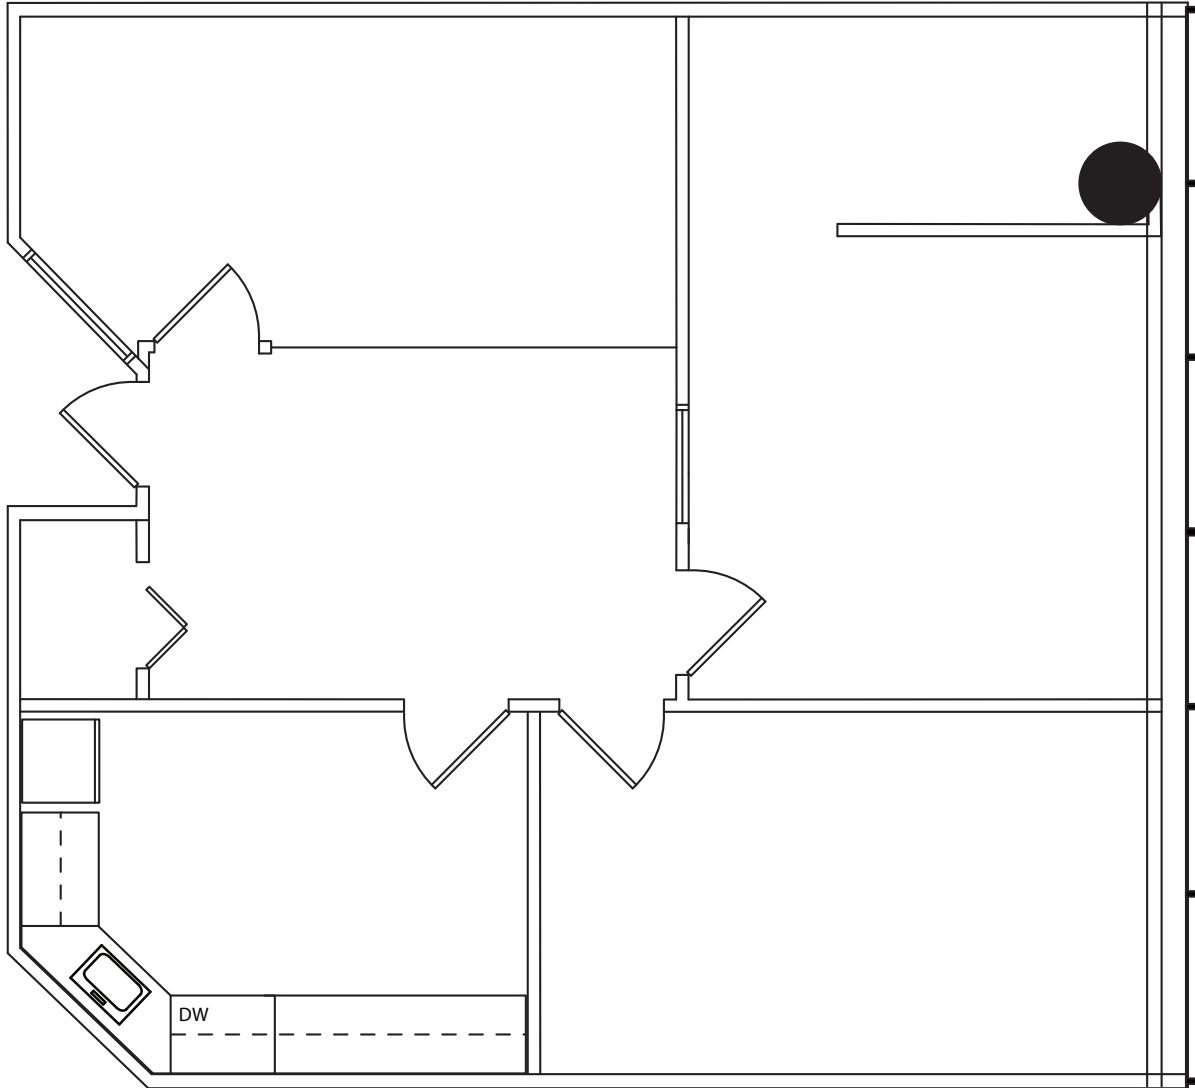

* Dimensions are Deemed
as Accurate but not to Scale

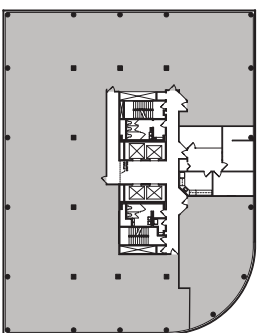

LEASED & MANAGED BY

