



HIGHLANDS

HIGHLANDS ONE @ FOREST PARK

Suite 250

As-Built

4,914 Sq. Ft.

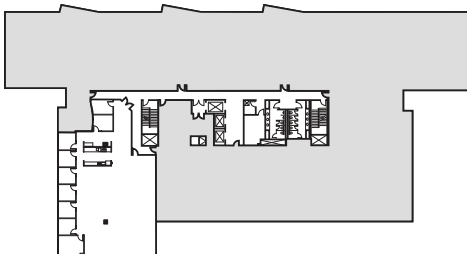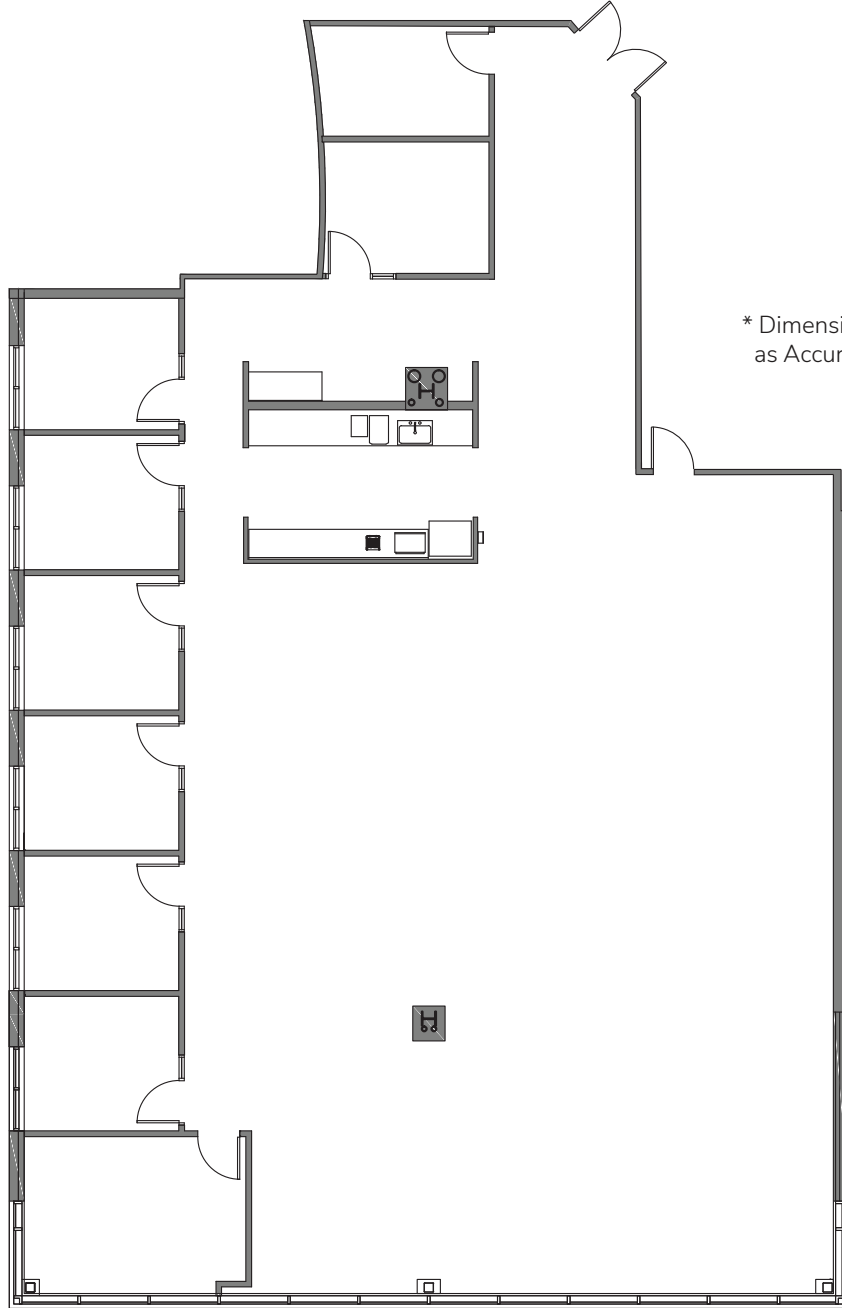

OWNED & MANAGED BY



LEASED BY

