




BROADWAY WEST


Suite 2615

As-Built

1,649 Sq. Ft.

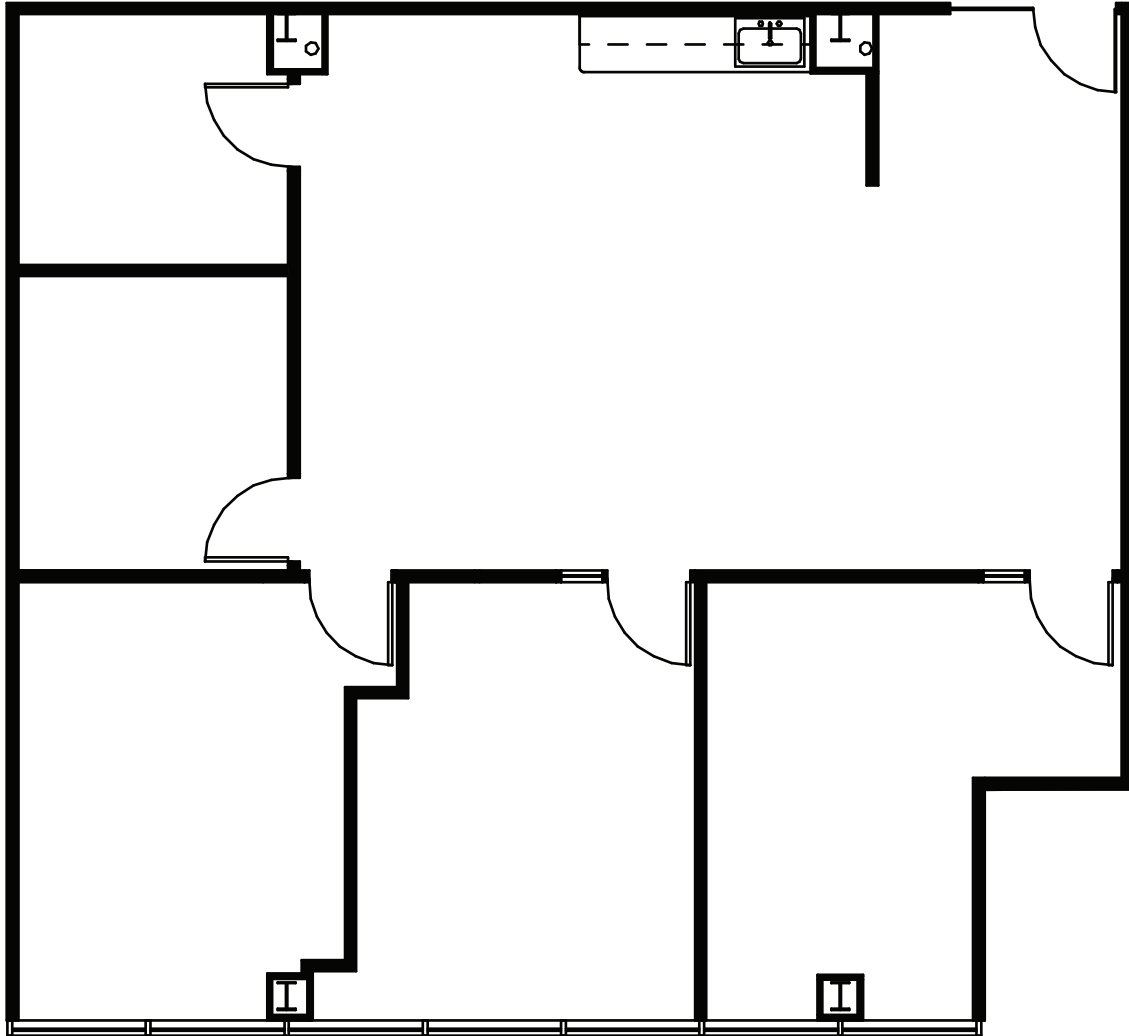

* Dimensions are Deemed
as Accurate but not to Scale

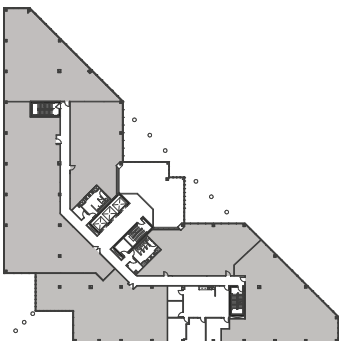

OWNED & MANAGED BY



LEASED BY

