



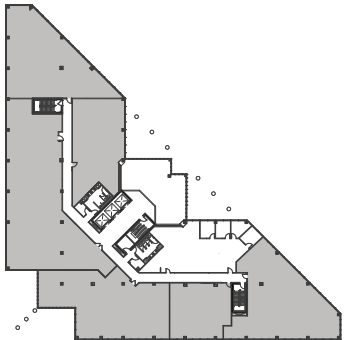

BROADWAY WEST

Suite 2650

As-Built 2,395 Sq. Ft.

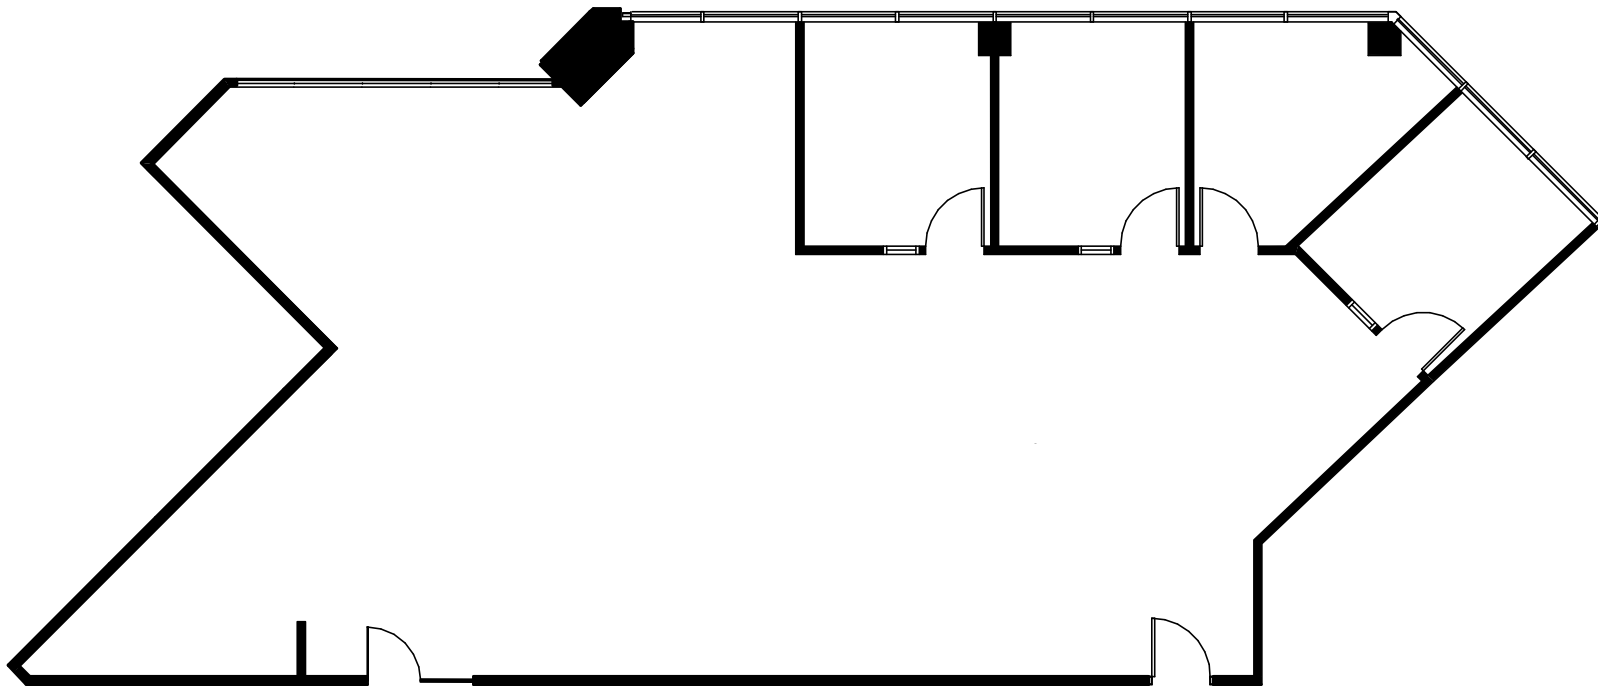

* Dimensions are Deemed
as Accurate but not to Scale

OWNED & MANAGED BY



LEASED BY

