
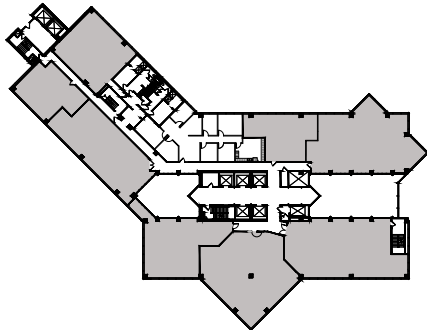


MINNESOTA CENTER

Suite 270

As-Built 1,945 Sq. Ft.

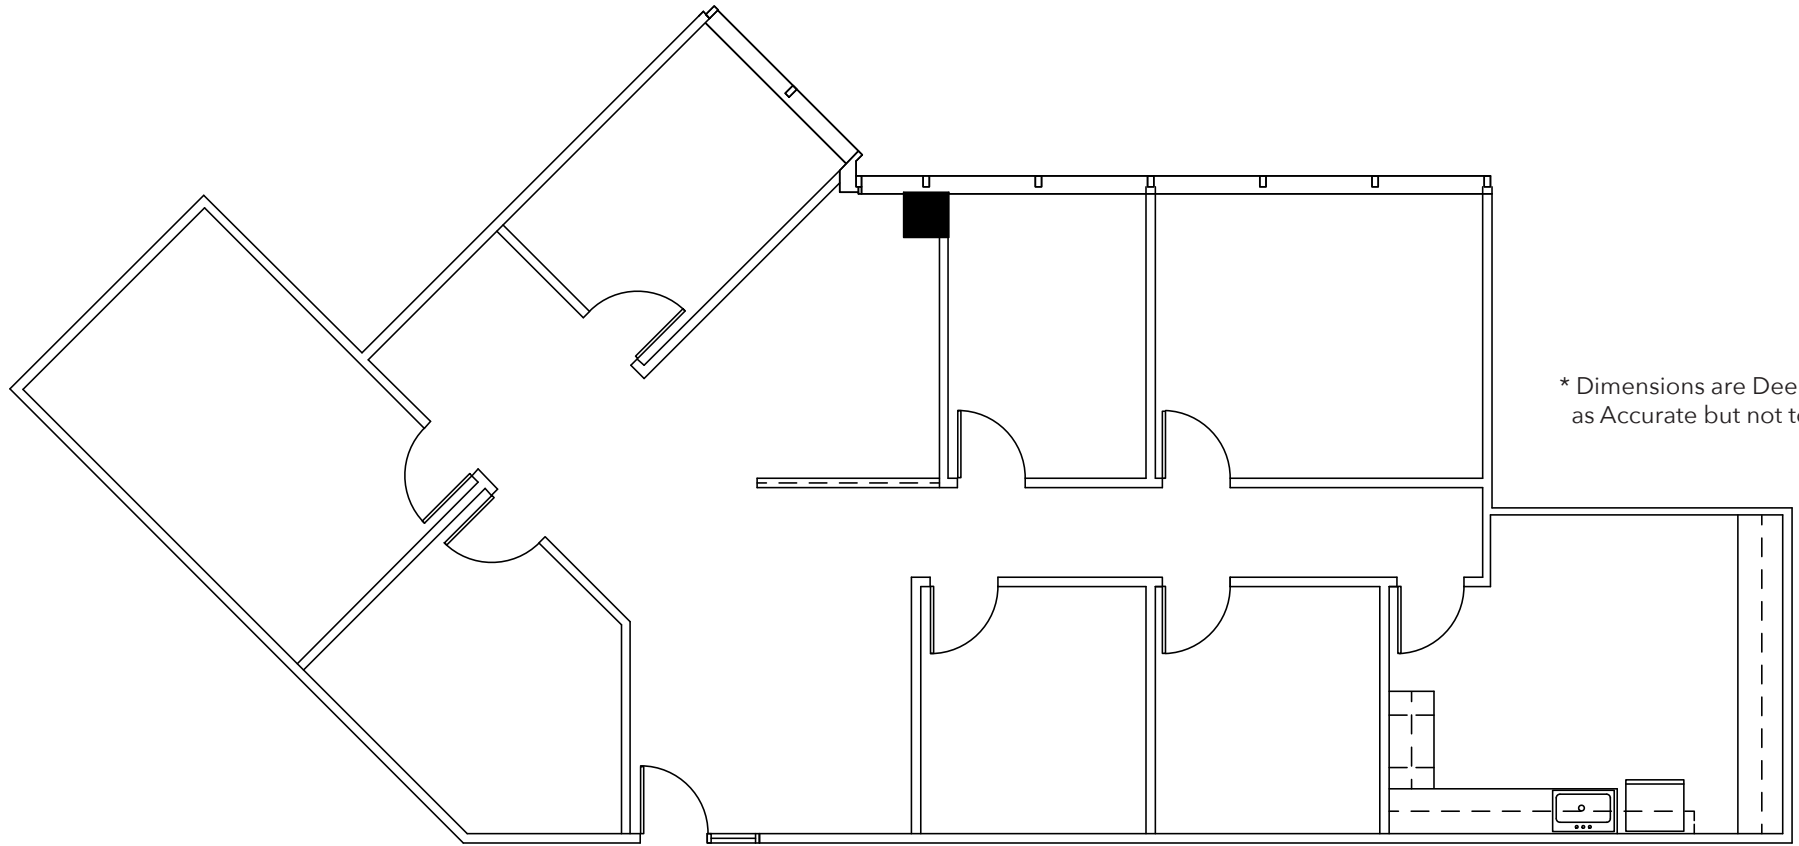

OWNED & MANAGED BY



LEASED BY

