


# OLYMPIC PLACE

Suite 300

As-Built 12,932 Sq. Ft.

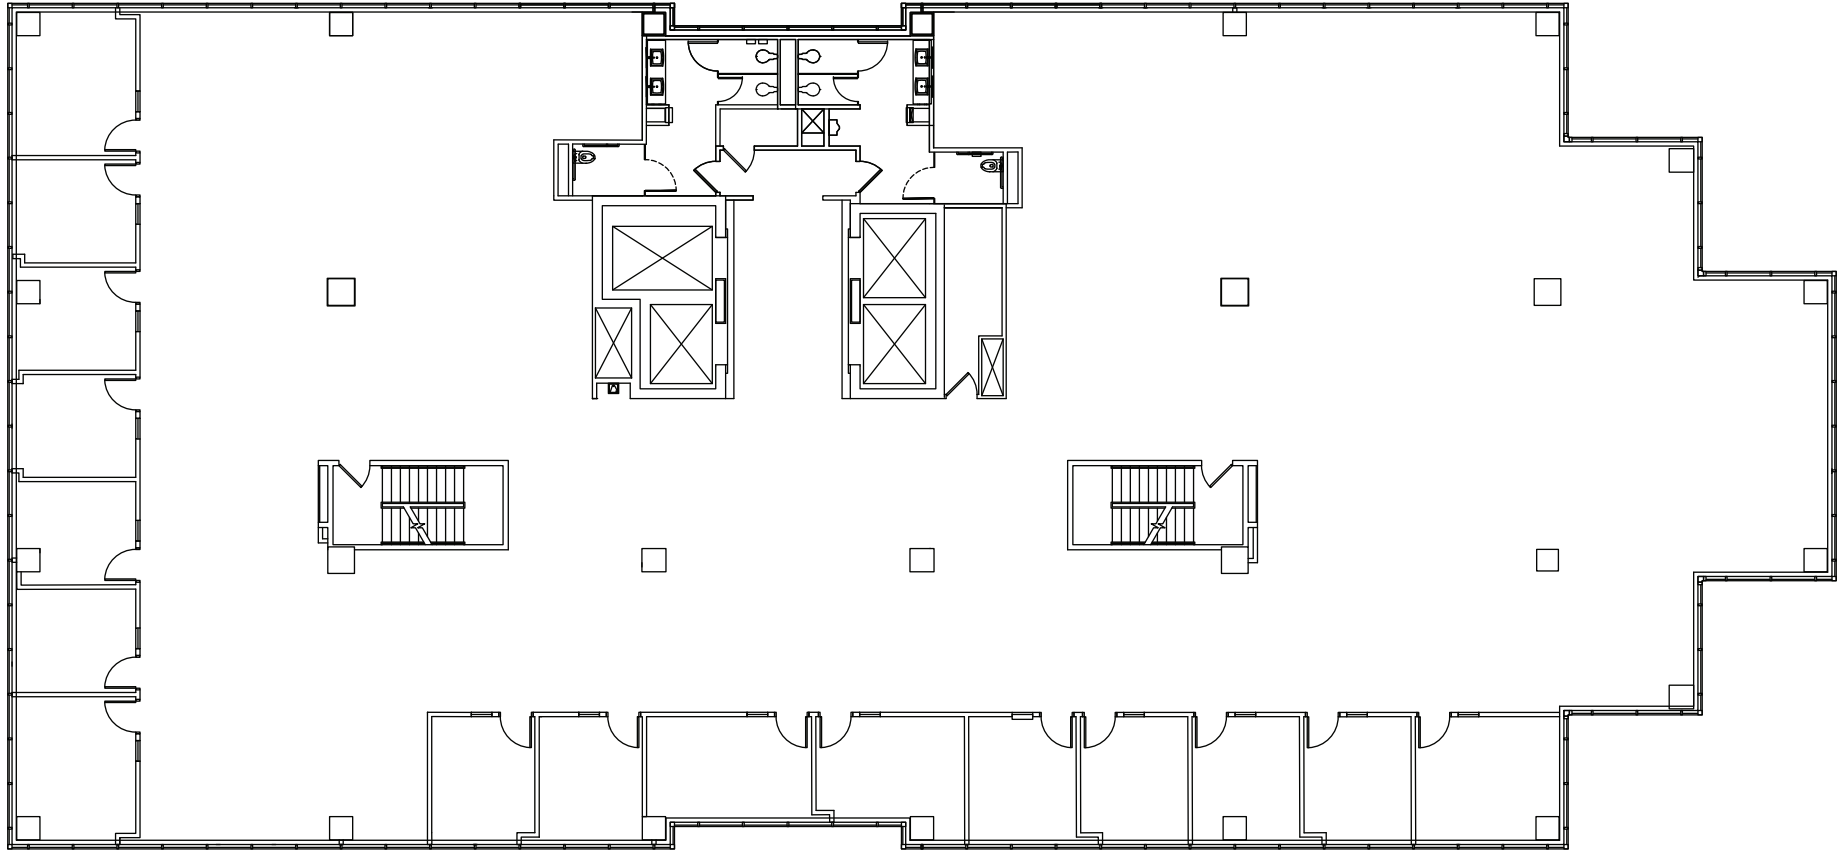

\* Dimensions are Deemed  
as Accurate but not to Scale

OWNED & MANAGED BY



LEASED BY

