


HIGHLANDS

HIGHLANDS ONE @ FOREST PARK

Suite 320

As-Built 6,750 Sq. Ft.

* Dimensions are Deemed
as Accurate but not to Scale

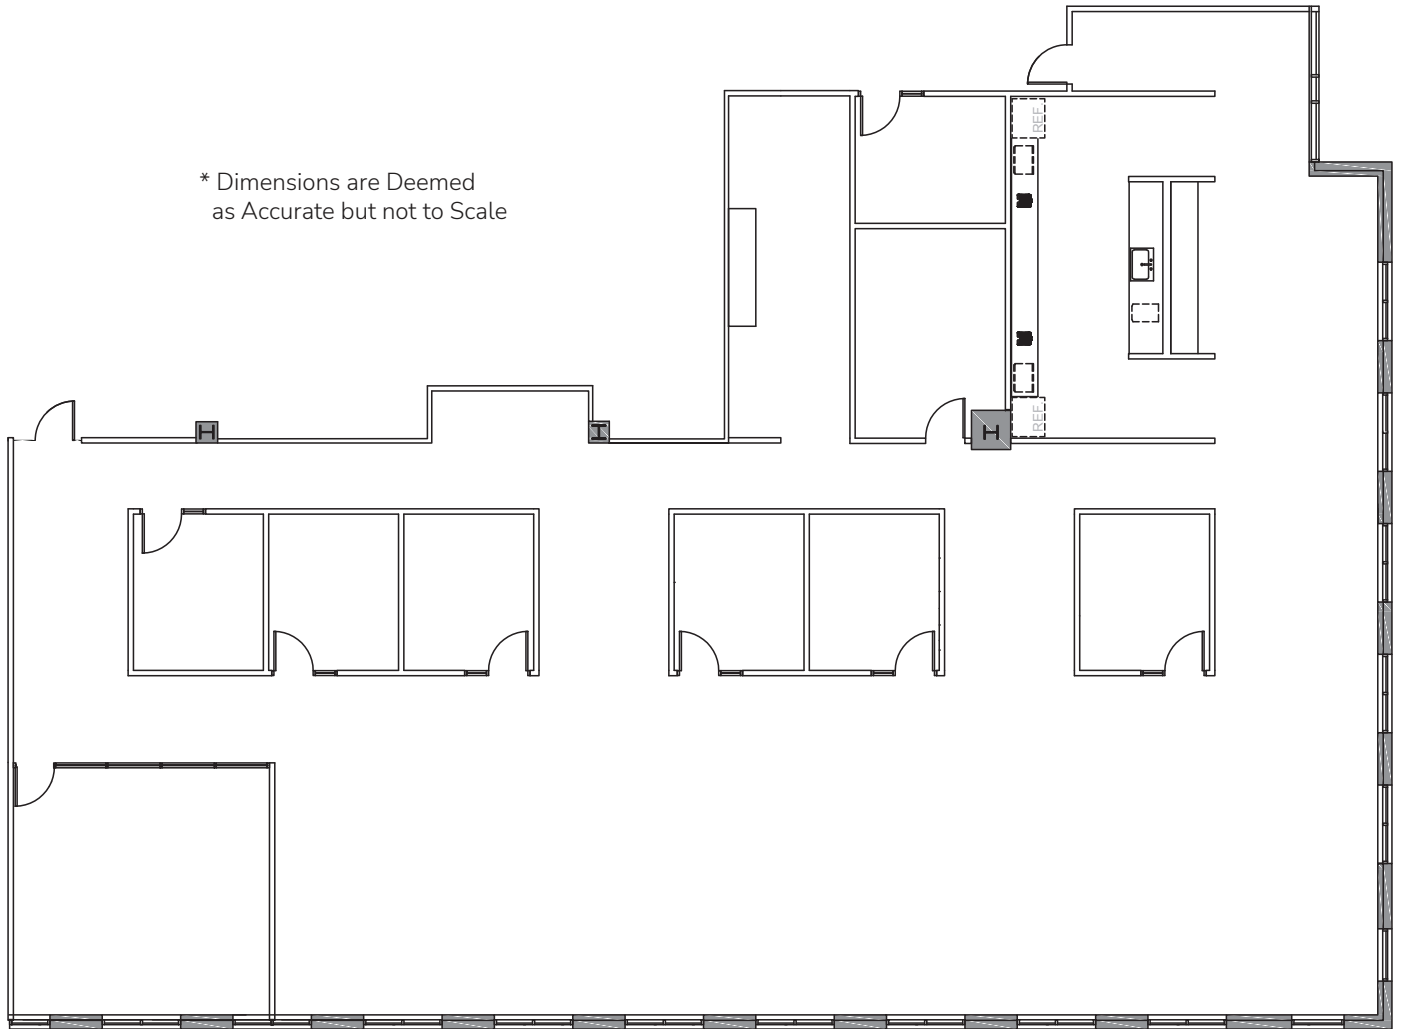

LEASED BY

NEWMARK
ZIMMER

OWNED & MANAGED BY

