


CIBC PLACE

Suite 325

As-Built 1,524 Sq. Ft.

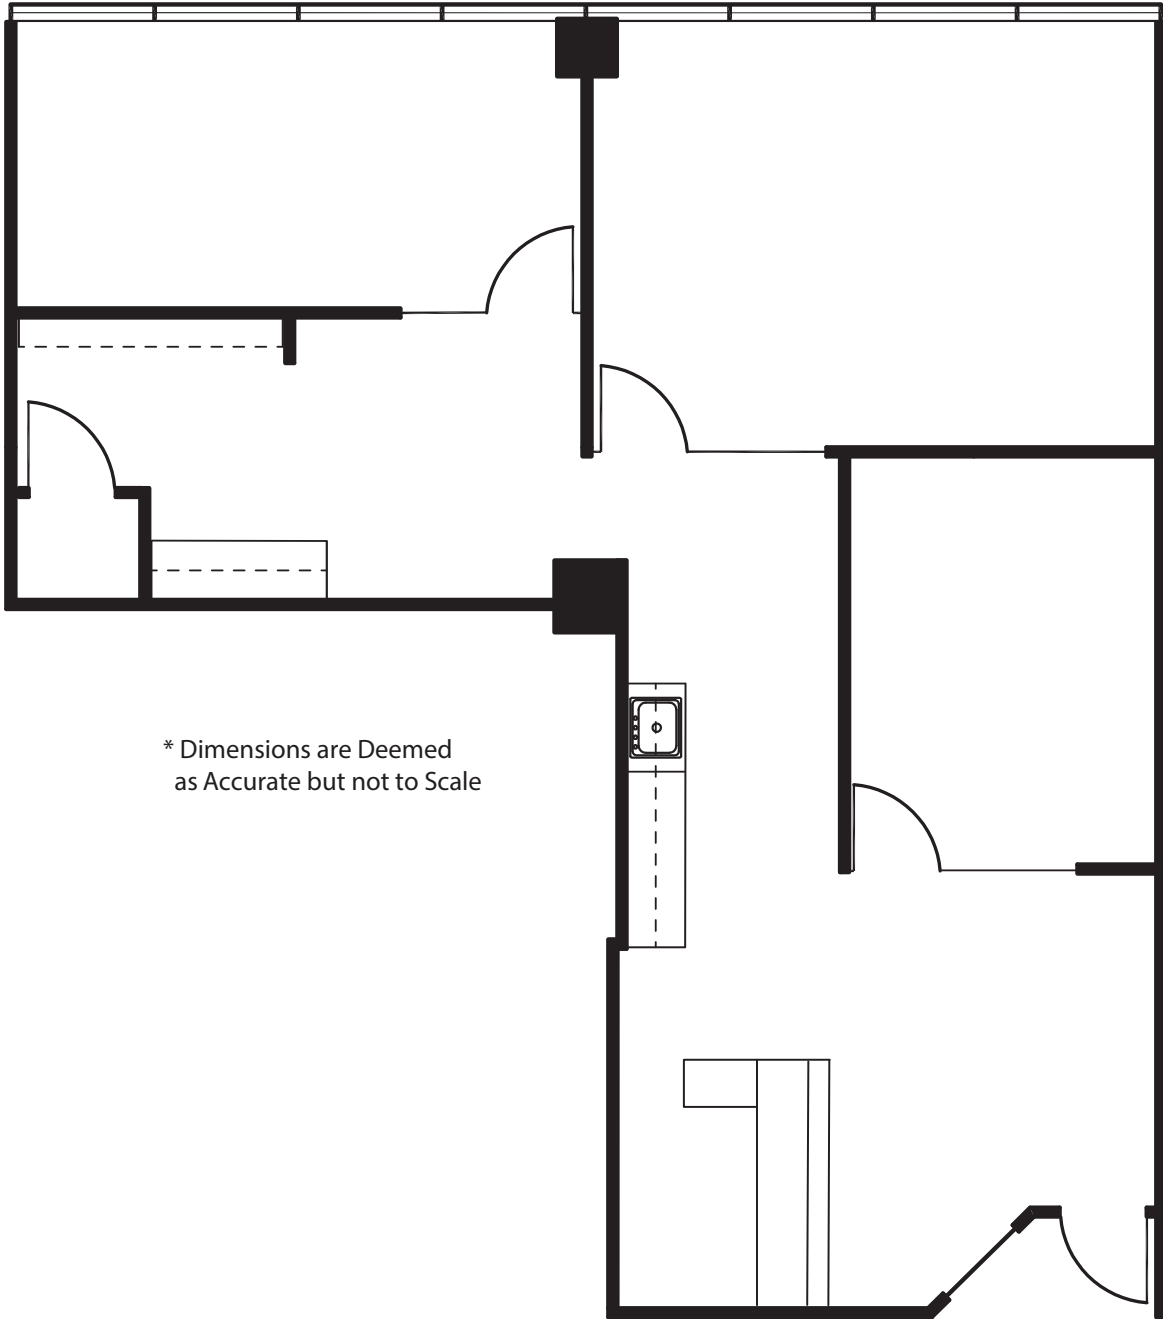

* Dimensions are Deemed as Accurate but not to Scale

