


# MINNESOTA CENTER

Suite 330

As-Built

2,752 Sq. Ft.

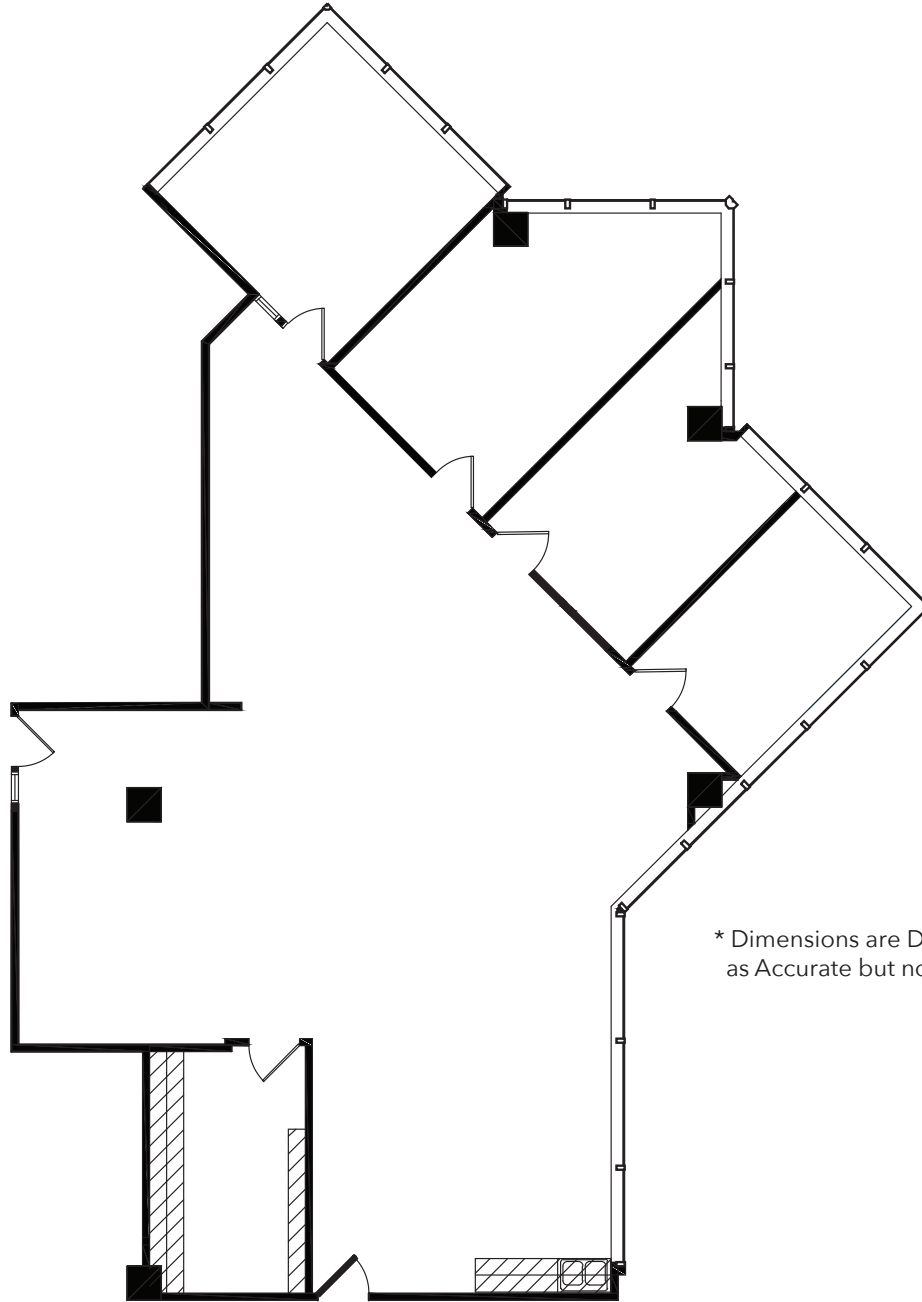

\* Dimensions are Deemed  
as Accurate but not to Scale

