



Suite 350

As-Built 4,466 Sq. Ft.

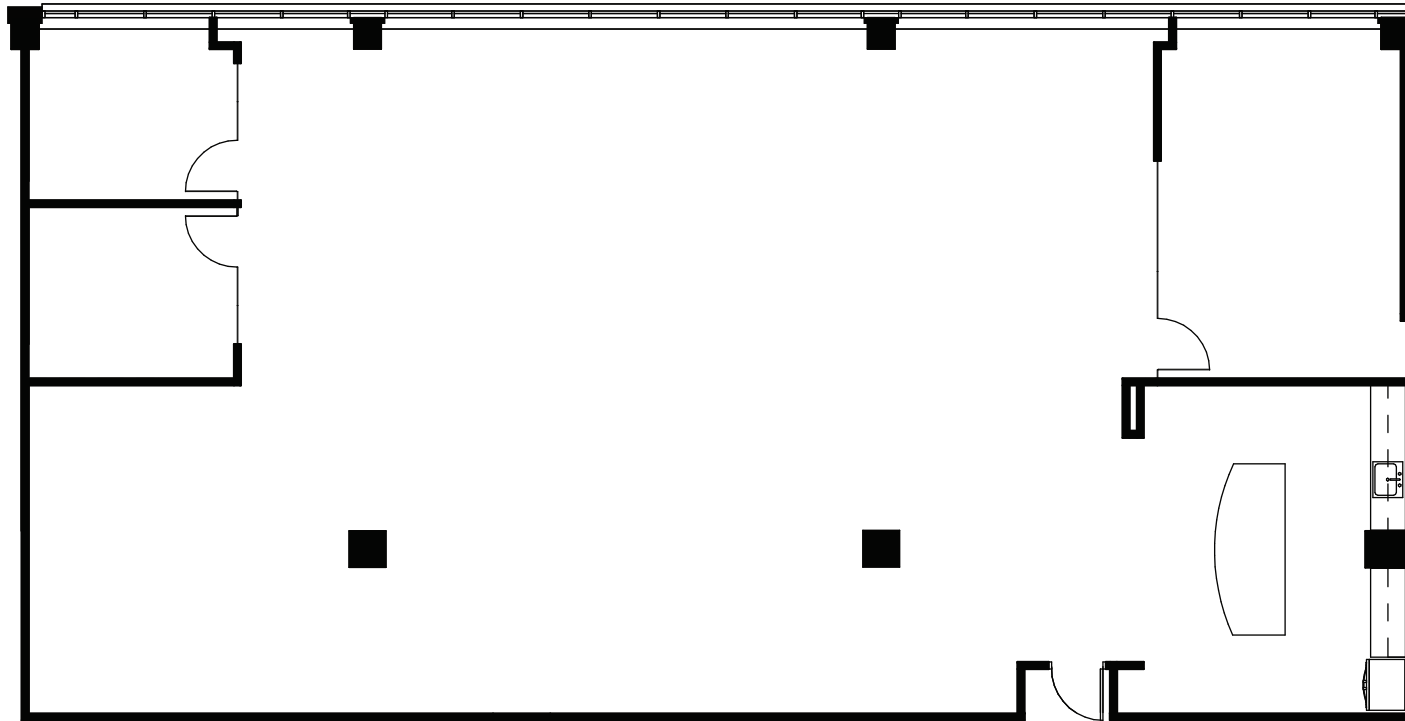

* Dimensions are Deemed as Accurate but not to Scale

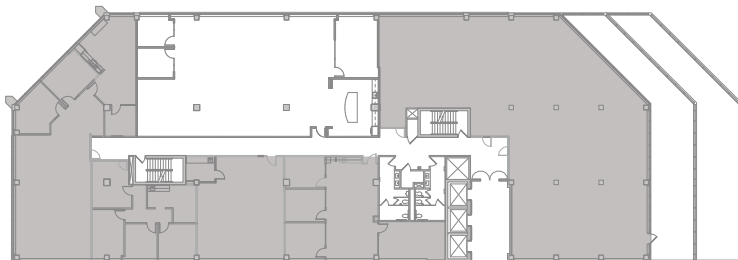

OWNED & MANAGED BY



LEASED BY

