


# WEST RIDGE


Suite 350

As-Built

2,827 Sq. Ft.

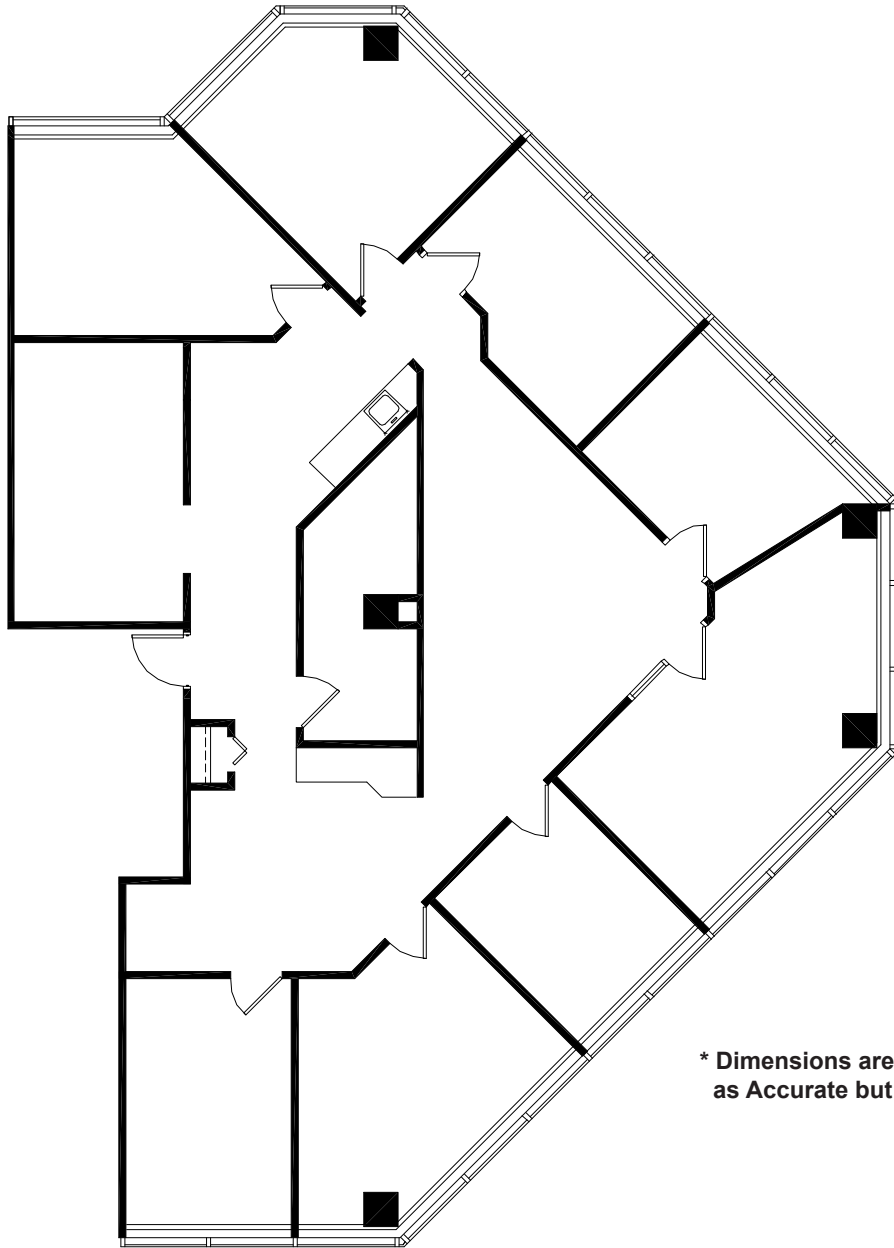

\* Dimensions are Deemed  
as Accurate but not to Scale

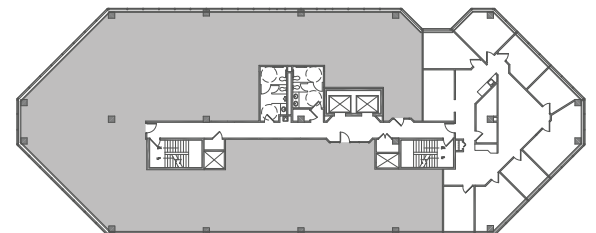

OWNED & MANAGED BY



LEASED BY

